

MICHIGAN  
DEPARTMENT OF CONSERVATION  
FORESTRY DIVISION

# LAND CORNER RECORD

T. 27  
26 N.R. 9 W


GRAND TRAVERSE COUNTY

DESCRIPTION OF CORNER 1/4 corner common to sections 32 & 5

CORNER MONUMENT Set Std. Dept. Mon.

DATE MONUMENT PLACED AND WITNESSED 8/15/68

WITNESSES TO CORNER..... Square Conc. mon. with steel fence post N2W 126.0'

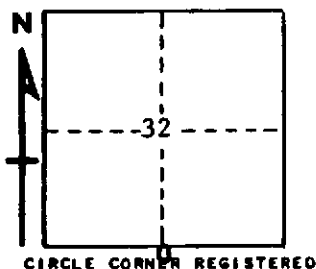

12" Red Pine	N 3 E	77.2'
9" Oak	N 81 W	32.9'
6" W. Pine	S 33 E	37.6'
AND		
E-W Random	Due S.	2.6'

DESCRIPTION IN DETAIL AS TO HOW CORNER WAS LOCATED AND IDENTIFIED OR RESTORED.

This corner was set by single proportion between found Sec. cor to E & W.

Pine stump remains for probable USBT to NE fits within one foot. Schaaf notes dated 1933 show that he had an original corner here. This corner fits very close to where Carver survey data of 1927 placed the corner by single proportion.

SURVEYOR'S SEAL

SIGNED Carl F. Roeder DATE 8/15/68  
REGISTERED LAND SURVEYOR #12028