

MICHIGAN  
DEPARTMENT OF CONSERVATION  
FORESTRY DIVISION

# LAND CORNER RECORD

T. 27 N.R. 9 W


GRAND TRAVERSE COUNTY

DESCRIPTION OF CORNER 1/4 corner common to sections 30 & 31

CORNER MONUMENT Set Std. Dept. Mon.

DATE MONUMENT PLACED AND WITNESSED 8/2/68

WITNESSES TO CORNER.....

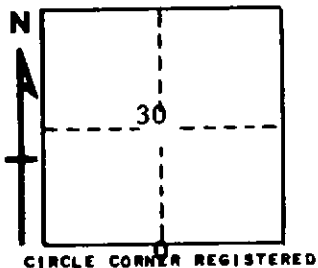

	5" Oak	N 15 E	17.6'
	5" Oak	S 88 E	11.5'
	9" Oak	N 30 W	34.7'
AND	E-W Random	Due N	52'

DESCRIPTION IN DETAIL AS TO HOW CORNER WAS LOCATED AND IDENTIFIED OR RESTORED.

This corner was set by single proportion between section corners to E & W.

SURVEYOR'S SEAL

SIGNED Carl F. Rose DATE 9/16/68  
REGISTERED LAND SURVEYOR #12028