

MICHIGAN
DEPARTMENT OF CONSERVATION
FORESTRY DIVISION

LAND CORNER RECORD

T. 27 N.R. 9 W


GRAND TRAVERSE COUNTY

DESCRIPTION OF CORNER Sec. corner common to sections 20-21-28-29

CORNER MONUMENT Set Std. Dept. Mon. (buried) & Cedar Post 1 rod W. Of Mon.

DATE MONUMENT PLACED AND WITNESSED 8/2/68

WITNESSES TO CORNER.....

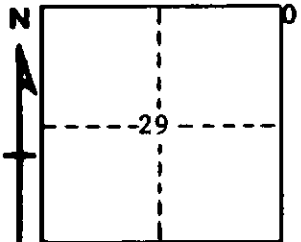

CIRCLE CORNER REGISTERED

7" Oak	S 46 E	15.8'
5" Maple in clump	N 33 E	26.7'
9" Twin Oak	S 72 W	14.8'
AND Center N-S Fire Lane Trail Road	Due W	2'
Center Fire Lane Trail Rd. East	Due N	8'

DESCRIPTION IN DETAIL AS TO HOW CORNER WAS LOCATED AND IDENTIFIED OR RESTORED.

This corner was set by double proportion between 1/4 corner N, Sec. corner W., Sec. corner S., & 1/4 corner E. It fits the calls in Schaaf notes to USBT Y. Pine Stump N 35 E, 55.4'. (US was Y Pine 18 N35W 53').

SURVEYOR'S SEAL

SIGNED *Paul F. Rosen* DATE 9/16/68
REGISTERED LAND SURVEYOR #12028