

LAND CORNER RECORDATION CERTIFICATE
FILING REQUIREMENT OF ACT 74, MICH. P.A.1970

FOR CORNERS OF-- LOCATED IN-- CORNER CODE NUMBER
1. PUBLIC LAND SURVEY T. 27 N. R. 9 W. I-8; J-7; J-8; J-9
2. PROPERTY CONTROLLING IN SECTION T. S. R. E. W.
3. MISCELLANEOUS PROPERTY IN SECTION T. S. R. E. W.
4. LOT NO. RECORDED PLAT
5. PRIVATE CLAIMS

REGISTER OF DEEDS STAMP AND FILING NUMBER

I, Carl F. Roser do hereby certify that under requirements of P.A. 74, Michigan P.A. of 1970, the corner points mentioned in lines 1 and 2 above (identified with circles on index code diagram - over) were, in a field survey on 6-20 1973, established, re-established, monumented, re-monumented, recovered or restored as expressed below and in conformance with regulations and rules therefore as required in the current manual of survey instructions of the United States Department of the Interior, Bureau of Land Management or by a decree of a court of law.

A. Description of original monument and accessories and/or subsequent restoration
C. Continued J-9

- Set DNR Mon & Cedar Gd Post
12" W. Pine S37E 41.9'
12" W. Pine N60E 42.2
16" R. Pine N26E 64.2
10" R. Pine N73W 51.0
Ctr Firelane N Due E 7'
Ctr E-W firelane Due S 15'

- B. Description of corner evidence found and/or method applied in restoring or re-establishing corner:
I-8 Recovered both of E. P. Waterman's W.P. wit. stumps to recovered GLO corner per sur. of Record, Liber 2, Page 447; Oct. 1912.
J-7 Recovered concrete monument per survey by RLS Pete Perla for Cons. Power Company.
J-8 Established corner per standard BLM instructions.
J-9 Restored corner from Schaaf Pits - Schaaf's notes indicate he had an original corner.

C. Description of monument for corner and accessories established to perpetuate locating the position of the corner:

- I-8 Set DNR Mon, buried.
6" W. Pine S67E 43.8'
7" W. Pine S64W 65.7'
8" W. Pine N60W 37.0'
Approx ctr N-S dirt road Due W 3'
Set Ced Post w/loc tag Due E 33'
J-7 Fd. 4" concrete mon.
18" W. Pine N28W 24.6
18" W. Pine S34E 45.3
16" W. Pine S53W 38.4
C. Line Fire lane South Due W 4'
Set Cedar Post w/loc tag Due N 33'
J-8 Set 1"x36" pipe
6" W. Pine N73E 44.9
8" W. Pine S54E 34.3
6" W. Pine S25W 27.7
6" W. Pine N41W 35.1
Ctr N-S fire lane Due E 2'
Set Ced post w/loc tag Due W 16.5'


SIGNED BY Carl F. Roser DATE 7-16-73

SURVEYOR'S MICHIGAN REGISTRATION NO. 12028

FOR STATE AND UNITED STATES AGENCIES:

SIGNED BY CHIEF OF SURVEY PARTY DATE

APPROVED AND SIGNED BY MICHIGAN REGISTERED LAND SURVEYOR DATE

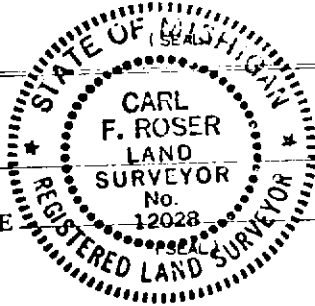

SURVEYOR'S MICHIGAN REGISTRATION NO.