

# LAND CORNER RECORDATION CERTIFICATE

## FILING REQUIREMENT OF ACT 74, MICH. P.A.1970

| FOR CORNERS OF--:                          | LOCATED IN--:  | CORNER CODE NUMBER |
|--|--|--------------------|
| 1. PUBLIC LAND SURVEY _____                | T. 27 <sup>N.</sup> <input checked="" type="radio"/> R. 9 <sup>W.</sup> <input checked="" type="radio"/> | A-4; B-4           |
| 2. PROPERTY CONTROLLING IN SECTION 7 _____ | T. 27 <sup>N.</sup> <input checked="" type="radio"/> R. 9 <sup>W.</sup> <input checked="" type="radio"/> | 12; 15             |
| 3. MISCELLANEOUS PROPERTY IN SECTION _____ | T. _____ <sup>N.</sup> <input type="radio"/> R. _____ <sup>E.</sup> <input type="radio"/>                | _____              |
| 4. LOT NO. _____, RECORDED PLAT _____      |  |                    |
| 5. PRIVATE CLAIMS _____                    |  |                    |

REGISTER OF DEEDS STAMP AND FILING NUMBER

I, Carl F. Roser, do hereby certify that under requirements of P.A. 74, Michigan P.A. of 1970, the corner points mentioned in lines 1 and 2 above were, in a field survey on March 30, 1976, established, re-established, monumented, re-monumented, recovered or restored as expressed below and in conformance with regulations and rules therefore as required in the current manual of survey instructions of the United States Department of the Interior, Bureau of Land Management or by a decree of a court of law. Furthermore, that the corner points mentioned in lines 3, 4 and 5 above were, in a field survey on \_\_\_\_\_, 19\_\_\_\_, found, recovered, restored, established or re-established as expressed below and in conformance with the rules of the Michigan State Board of Registration for Land Surveyors or, by a Decree of a Court of law:

~~A = Description of original monument and accessories and/or subsequent restoration~~  
 C. (continued) 15

Fd. 3/4" iron rod-cedar post  
 w/loc. tag  
 11" Oak      S54°E      9.5  
 10" Oak      S05°E      16.5  
 12" Oak      S73°W      18.9

B. Description of corner evidence found and/or method applied in restoring or re-establishing corner:


- A-4 Restored W 1/4 corner, Sec. 7 (27-9) at old corner fence post, fence remains S & E. This fits EP Waterman survey of Sec. 7, dated 1916, Liber 10, page 23 (also see T27N-R10W)M-4.
- B-4 Recovered 3/4" rod for center of Sec. 7 per Waterman survey dated 1916, Liber 10, page 23. Old N-S r-o-w fence is Due E 31.5'. Old fence corner (fence S & W) is Due W 33.0'.
- 12 Recovered 1" axle shaft per Waterman survey of Sec. 7 dated 1907, Liber 1, page 515 and dated 1916, Liber 10, page 23. Corner is in line with gravel road to W and is 25'± W of dirt trail N and gravel road S.
- 15 Found 3/4" iron rod that fits Waterman survey of Sec. 7 dated 1916. Corner falls in old E-W fence remains.

C. Description of monument for corner and accessories established to perpetuate locating the position of the corner:

| A-4                          | B-4                                      | 12                          |
|------------------------------|--|-----------------------------|
| Set DNR Mon. & Cedar Post    | Fd. 3/4" iron rod w/square head (buried) | Fd. 1" axle shaft (buried)  |
| 7" Maple    N62°W    36.6    | 9" Maple    N48°E    38.1                | 12" Maple    N42°E    45.3  |
| 9" Maple    S17°W    24.5    | 20" Maple    S32°E    43.9               | 8" Hemlock    N43°W    62.0 |
| 10" Oak      N86°E    33.3   | 16" Maple    S58°W    38.3               | 7" Cedar      S58°W    60.9 |
| E 1/4 corner Sec. 12 (27-10) | Set cedar post w/loc. tag                | 4" W. Pine    S51°E    67.4 |
| N00°06'E    35.50            | Due W      33                            |                             |

SIGNED BY Carl F. Roser 4-28-77 DATE \_\_\_\_\_

SURVEYOR'S MICHIGAN REGISTRATION NO. 12028

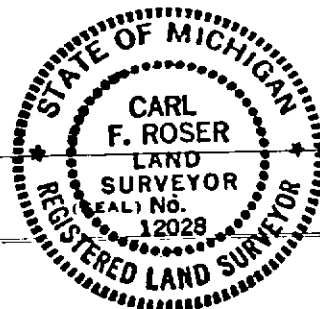

FOR STATE AND UNITED STATES AGENCIES:

SIGNED BY \_\_\_\_\_ DATE \_\_\_\_\_

APPROVED AND SIGNED BY \_\_\_\_\_ DATE \_\_\_\_\_

CHIEF OF SURVEY PARTY

MICHIGAN REGISTERED LAND SURVEYOR

(SEAL)

SURVEYOR'S MICHIGAN REGISTRATION NO. \_\_\_\_\_ GRAND TRAVERSE COUNTY

FORM APPROVED BY MICHIGAN STATE BOARD OF REGISTRATION, JAN. 28, 1971  
 REVISED MAY 14, 1975

MAY PLACE SKETCH ON BACK OR ATTACHED SHEET