

*Jansing Forestry*

# LAND CORNER RECORDATION CERTIFICATE

## FILING REQUIREMENT OF ACT 74, MICH. P.A.1970

FOR CORNERS OF --:	LOCATED IN --:	CORNER CODE NUMBER
1. PUBLIC LAND SURVEY _____	T. <u>27</u> N. R. <u>9</u> W.	I-7
2. PROPERTY CONTROLLING IN SECTION <u>23</u>	T. <u>27</u> N. R. <u>9</u> W.	Code 1; Code 8
3. MISCELLANEOUS PROPERTY IN SECTION _____	T. _____ N. S., R. _____ E. W.	
4. LOT NO. _____, RECORDED PLAT _____		
5. PRIVATE CLAIMS _____		

REGISTER OF DEEDS STAMP AND FILING NUMBER

I, Carl F. Roser do hereby certify that under requirements of P.A. 74, Michigan P.A. of 1970, the corner points mentioned in lines 1 and 2 above (identified with circles on index code diagram - over) were, in a field survey on 6-20 1973, established, re-established, monumented, re-monumented, recovered or restored as expressed below and in conformance with regulations and rules therefore as required in the current manual of survey instructions of the United States Department of the Interior, Bureau of Land Management or by a decree of a court of law. Furthermore, that the corner points mentioned in lines 3, 4 and 5 above were, in a field survey on \_\_\_\_\_ 19\_\_\_\_, found, recovered, restored, established or re-established as expressed below and in conformance with the rules of the Michigan State Board of Registration for Land Surveyors or, by a Decree of a Court of law:

A. Description of original monument and accessories and/or subsequent restoration:

B. Description of corner evidence found and/or method applied in restoring or re-establishing corner:

- I-7 Fd. 3/4" pipe in centerline N-S County dirt road per survey by RLS Pete Perla for Consumers Power Company.
- 1 Recovered 1 1/2" pipe in concrete by M. Schaaf as used by RLS Pete Perla in survey for Consumers Power Company.
- 8 Established corner per standard B.L.M. instructions.

C. Description of monument for corner and accessories established to perpetuate locating the position of the corner:

I-7		Code 1		Code 8	
Fd. 3/4" pipe. Monument, buried.	Added DNR	Fd. 1 1/2" pipe set in concrete		Set 1"x36" pipe & Ced post w/loc tag	
5" W. Pine	S52W 48.0'	5" W. Pine	S79W 60.7'	12" W. Pine	S63E 37.3'
12" W. Pine	N77E 67.1'	6" W. Pine	N56E 49.3'	9" W. Pine	S16E 25.5'
9" W. Pine	S49E 89.5'	5" W. Pine	S33E 40.6'	10" W. Pine	N61W 20.9'
Approx. E-W dirt rd.	Due N 5'±	Set Ced post w/loc tag	Due S 33'		


SIGNED BY Carl F. Roser DATE 7-16-73

SURVEYOR'S MICHIGAN REGISTRATION NO. 12028

FOR STATE AND UNITED STATES AGENCIES:

SIGNED BY \_\_\_\_\_ DATE \_\_\_\_\_  
CHIEF OF SURVEY PARTY

APPROVED AND SIGNED BY \_\_\_\_\_ DATE \_\_\_\_\_  
MICHIGAN REGISTERED LAND SURVEYOR

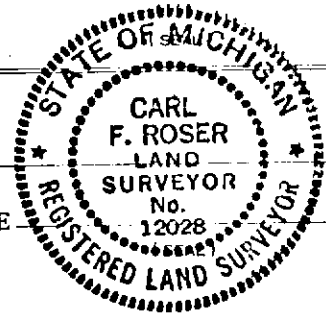

SURVEYOR'S MICHIGAN REGISTRATION NO. \_\_\_\_\_