

APR 26 1996

LAND CORNER RECORDATION CERTIFICATE
Filing Requirement of Act 74, Mich. P.A. 1970

COMMISSION
Grand Traverse
(County)

Located In: Corner Code #

- 1. Public Land Survey T 27N R 10W H-7
2. Property Controlling In Section S T R
3. Miscellaneous Property in Sec. S T R

STATE OF MICHIGAN
GRAND TRAVERSE COUNTY
RECORDED

29 DEC 95 9:52 A.M.

KARON ANDERSON
REGISTER OF DEEDS

Register of Deeds Stamp & File Number

- 4. Lot No. Recorded Plat
5. Private Claims

Gary G. Wilson December 21 95

I, Gary G. Wilson, in a field survey on December 21, 1995, do hereby certify that under requirements of P.A. 74, Michigan P.A. of 1970, the corner points mentioned in lines 1 and 2 above were in conformance with regulations and rules therefore as required in the current manual of survey instructions of the United States Department of the Interior, Bureau of Land Management or by a decree of a Court of Law and/or that the corner points mentioned in lines 3, 4 and 5 above were in conformance with the rules of the Michigan Board of Land Surveyors or by a Decree of a Court of Law; established, re-established, monumented, re-monumented, recovered, found as expressed below:

NOTE: Not more than 4 corners, all in the same town and range, may be recorded on this certificate.

Grid table with columns A-M and rows 2-13. A dot is marked at the intersection of column G and row 7.

A. Description of original monument and accessories and/or subsequent restoration:

H-7 1/4 Corner common to Sections 15 & 22

County Surveyor records: Slawson subdivided Section 22 and set corner midway on line in September 1876. Waterman found stake in September 1913 and finds post, stake and iron in July 1918.

Act 74 L.C.R. records: Walker sets corner in 1992. Case, in October 1994, documents corner iron as a perpetuation of Slawson Corner of 1876.

In November 1994, letter from Walker placed in record agreeing with location per the Case L.C.R.

B. Description of corner evidence found and/or method applied in restoring or reestablishing corner:


H-7 1/4 Corner common to Sections 15 & 22

Found 3/8" iron bar with 90 degree bend at top agreeing with witnesses listed by Case. Iron set by H. Walker was found 2.9 feet West of corner and was pulled.

Accepted as a careful and faithful perpetuation of the position of the original corner.

UNANIMOUSLY ACCEPTED BY THE GRAND TRAVERSE COUNTY PEER REVIEW GROUP AS THE OFFICIAL CORNER UNDER MICHIGAN PUBLIC ACT 345 OF 1990 AT A MEETING HELD ON 12-11-95

RFM
ROBERT F. MITCHELL, P.S., CI, ALHMAN

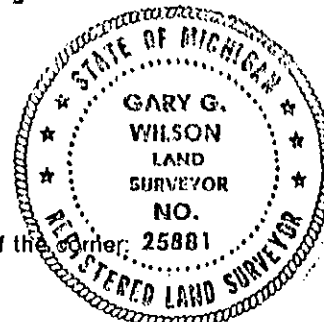

C. Description of monument for corner and accessories established to perpetuate locating the position of the corner:

H-7 1/4 Corner common to Sections 15 & 22

Perpetuated with 2-1/2" x 30" flanged bottom galvanized iron pipe with 3-1/2" brass cap stamped GRAND TRAVERSE COUNTY REMONUMENTATION.

- N20 degree E 35.22' Twin 12" Oak
S45 degree E 28.22' 10" Poplar
S15 degree W 35.72' 24" Oak stump
S80 degree W 22.77' 20" Maple

Corner approved by the Grand Traverse County Peer Review Group on December 11, 1995.

Signed by Gary G. Wilson

Date 12-27-95

Surveyor's Michigan License No. 25881 Gary G. Wilson