

STATE OF MICHIGAN
DEPARTMENT
OF
NATURAL RESOURCES

LAND CORNER RECORD

GRAND TRAVERSE COUNTY


T 27 N R 10 W

DESCRIPTION OF CORNER 1/4 corner common to Sections 10 - 11

CORNER MONUMENT Found stone with 1/4 S & Cross cut in top. Added Std. Dept.
Monument buried in West edge of N-S Trail Rd.

DATE MONUMENT PLACED AND WITNESSED 12-4-69

WITNESSES TO CORNER.....

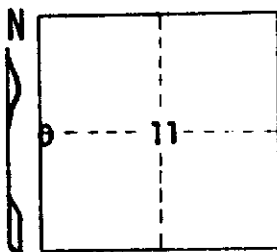

24" S. Maple N 20 E 92.1'

12" Twin Oak N 83 E 50.0'

AND


Fn Line E Due N 12.5'

CIRCLE CORNER REGISTERED

DESCRIPTION IN DETAIL AS TO HOW CORNER WAS LOCATED AND IDENTIFIED OR RESTORED.

This corner was recovered while working with Pete Perla, local private land surveyor, in order to locate or establish the corner, and have it acceptable to the private land owner and the Department.

Found corner from survey records which are located in the Deed Office, C.P. Tuller, L.1-P.267, 1891; namely, stone with 1/4S and cross on top. We were able to locate the stone, buried at west edge of N-S Trail Road from one old witness, remains of 28" W. Pine stump, S 23°40'W, 46'. We added a Std. Dept. Monument and left the stone buried and along side of the Dept. Monument.

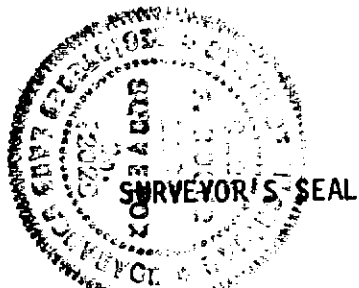

SIGNED

Carl F. Rover
REGISTERED LAND SURVEYOR

DATE 12-11-69

12028

DISTRIBUTION:

County Courthouse
Area Forester (Regions I & II)
District or Region Surveyor
Forestry Div., Lansing

R 4047
Rev. 10/68