

MAR 16 1994

LAND CORNER RECORDATION CERTIFICATE  
Filing Requirement of Act 74, Mich. P.A. 1970

For corners in  
**GRAND TRAVERSE**  
(County)

Located In:	Corner Code #:
T <u>27N</u> R <u>11W</u>	<u>L-11</u>
T _____ R _____	_____
T _____ R _____	_____
T _____ R _____	_____
T _____ R _____	_____
S _____ T _____ R _____	_____
S _____ T _____ R _____	_____
S _____ T _____ R _____	_____
S _____ T _____ R _____	_____

STATE OF MICHIGAN  
GRAND TRAVERSE COUNTY  
RECORDED  
30 DEC 93 10:45 A.M.  
KARON ANDERSON  
REGISTER OF DEEDS

Register of Deeds Stamp & File Number

- 4. Lot No. \_\_\_\_\_, Recorded Plat \_\_\_\_\_
- 5. Private Claims \_\_\_\_\_

A	B	C	D	E	F	G	H	I	J	K	L	M
2	6	5	4	3	2	1						
3												
4	7	8	9	10	11	12						
5												
6	18	17	16	15	14	13						
7												
8	19	20	21	22	23	24						
9												
10	30	29	28	27	26	25						
11												
12	31	32	33	34	35	36						
13												

I, Gary G. Wilson, in a field survey on December 17, 19 93, do hereby certify that under requirements of P.A. 74, Michigan P.A. of 1970, the corner points mentioned in lines 1 and 2 above were in conformance with regulations and rules therefore as required in the current manual of survey instructions of the United States Department of the Interior, Bureau of Land Management or by a decree of a Court of Law and/or that the corner points mentioned in lines 3, 4 and 5 above were in conformance with the rules of the Michigan Board of Land Surveyors or by a Decree of a Court of Law; established, re-established, monumented, re-monumented, recovered, found as expressed below:

NOTE: Not more than 4 corners, all in the same town and range, may be recorded on this certificate.

A. Description of original monument and accessories and/or subsequent restoration:

L-11: Original G.L.O. notes and witnesses.  
In March 1880, Hodgman found stake, one B.T. and stump of other (per Liber 1, Pg. 203). In 1903, E.H. Allyn set stake which came in line with fences North and South (per Liber 3, Pg. 232; Liber 2, Pg. 110; Liber 10, Pg. 273). In 1958, G.T. Co. Road Commission witness card shows white stone found. In April 1967, Consumers Power Co. survey by P. Perla shows iron pipe found and witnesses check.

B. Description of corner evidence found and/or method applied in restoring or reestablishing corner:


L-11: No physical evidence of the original GLO witnesses were found.  
Found pipe with cap #5942 (Perla) in monument box in centerline of Spring Hill Road (paved) 5 ft., more or less, East of fence line extended South. Consumers Power Co. witnesses check.

C. Description of monument for corner and accessories established to perpetuate locating the position of the corner:

L-11: 1/4 corner common to Sections 25 & 36  
Perpetuated with 2-1/2" X 30" flanged bottom galvanized iron pipe with 3-1/2" brass cap stamped GRAND TRAVERSE COUNTY REMONUMENTATION.

- N07°E 46.86' Power Pole
- N56°W 59.35' Apple Tree
- S02°W 35.12' 6" Ash
- N78°E 160.57' Power Pole

Corner approved by the Grand Traverse County Peer Review Group on 12-15-93 GW

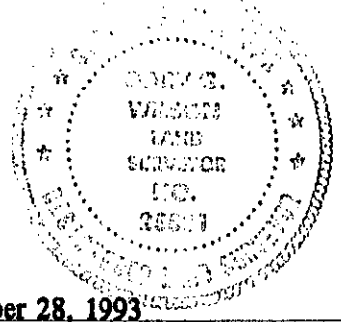

Signed by Gary G. Wilson Date December 28, 1993  
Surveyor's Michigan License No. 25881