

1993

COMMISSION

LAND CORNER RECORDATION CERTIFICATE
Filing Requirement of Act 74, Mich. P.A. 1970

STATE OF MICHIGAN
COUNTY OF LEELANAU
RECEIVED FOR RECORD

1993 DEC 28 PM 4: 26

Barbara Kirt
REGISTER OF DEEDS

FILE #334

LIBER 2 PAGE 31

Register of Deeds Stamp & File Number

For corners in

Leelanau
(County)

Located In:

Corner Code #

- | | | |
|---------------------------------------|---------------------------|------------|
| 1. Public Land Survey | T <u>28N</u> R <u>11W</u> | <u>A-2</u> |
| | T _____ R _____ | _____ |
| | T _____ R _____ | _____ |
| | T _____ R _____ | _____ |
| 2. Property Controlling in Section | S _____ T _____ R _____ | _____ |
| | S _____ T _____ R _____ | _____ |
| 3. Miscellaneous Property in Sec. | S _____ T _____ R _____ | _____ |
| | S _____ T _____ R _____ | _____ |
| 4. Lot No. _____, Recorded Plat _____ | | |
| 5. Private Claims _____ | | |

I, Steven P. Bye, in a field survey on November 30, 19 93, do hereby certify that under requirements of P.A. 74, Michigan P.A. of 1970, the corner points mentioned in lines 1 and 2 above were in conformance with regulations and rules therefore as required in the current manual of survey instructions of the United States Department of the Interior, Bureau of Land Management or by a decree of a Court of Law and/or that the corner points mentioned in lines 3, 4 and 5 above were in conformance with the rules of the Michigan Board of Land Surveyors or by a Decree of a Court of Law; established, re-established, monumented, re-monumented, recovered, found as expressed below:

NOTE: Not more than 4 corners, all in the same town and range, may be recorded on this certificate.

	A	B	C	D	E	F	G	H	I	J	K	L	M
2	6	5	4	3	2	1							
3													
4	7	8	9	10	11	12							
5													
6	18	17	16	15	14	13							
7													
8	19	20	21	22	23	24							
9													
10	30	29	28	27	26	25							
11													
12	31	32	33	34	35	36							
13													

A. Description of original monument and accessories and/or subsequent restoration:

A-2: W 1/4 corner Section 6: G.L.O. notes - "Set 1/4 section post"
Elm 16, S 27 W, 20 links
Beech 9, N 74 E, 17 links


B. Description of corner evidence found and/or method applied in restoring or reestablishing corner:

A-2: W 1/4 corner Section 6: Bar and cap #13030 found in E-W wire mesh fence

C. Description of monument for corner and accessories established to perpetuate locating the position of the corner:

A-2: W 1/4 corner Section 6: Bar and cap #13030 accepted by the Leelanau County Remonumentation Peer Group meeting dated November 29, 1993. Bar and cap replaced with a 3/4" i.d galvanized pipe 3' long with a 3/4" brass cap.

T.P. of 6" x 14" x 18" stone - S 02 W, 3.25'
Power pole in fenceline - South 46.42'
4" elm in fenceline - North 174.99'
14" & 16" double chinese elm - East 495.04'

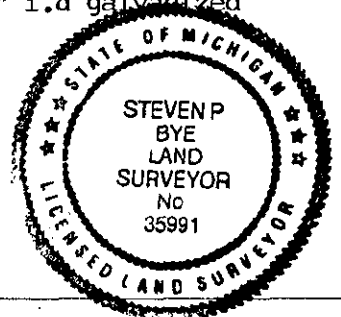

Signed by *Steven P. Bye*
Surveyor's Michigan License No. 35991

Date 12-20-93