

1993

COMMISSION

STATE OF MICHIGAN  
COUNTY OF LEELANAU  
RECEIVED FOR RECORD

1993 DEC 28 PM 4: 25

LAND CORNER RECORDATION CERTIFICATE  
Filing Requirement of Act 74, Mich. P.A. 1970

*Barbara Kirt*  
REGISTER OF DEEDS

FILE # 332

LIBER 2 PAGE 29

Register of Deeds Stamp & File Number

For corners in

Leelanau  
(County)

Located In:

Corner Code #

- |                                    |   |            |   |            |            |
|------------------------------------|---|------------|---|------------|------------|
| 1. Public Land Survey              | T | <u>28N</u> | R | <u>11W</u> | <u>B-1</u> |
|                                    | T | _____      | R | _____      | _____      |
|                                    | T | _____      | R | _____      | _____      |
|                                    | T | _____      | R | _____      | _____      |
| 2. Property Controlling in Section | S | _____      | T | _____      | _____      |
|                                    | S | _____      | T | _____      | _____      |
| 3. Miscellaneous Property in Sec.  | S | _____      | T | _____      | _____      |
|                                    | S | _____      | T | _____      | _____      |

4. Lot No. \_\_\_\_\_, Recorded Plat \_\_\_\_\_
5. Private Claims \_\_\_\_\_

	A	B	C	D	E	F	G	H	I	J	K	L	M
2	6	5	4	3	2								
3													
4	7	8	9	10	11	12							
5													
6	18	17	16	15	14	13							
7													
8	19	20	21	22	23	24							
9													
10	30	29	28	27	26	25							
11													
12	31	32	33	34	35	36							
13													

I, Steven P. Bye, in a field survey on December 15, 1993, do hereby certify that under requirements of P.A. 74, Michigan P.A. of 1970, the corner points mentioned in lines 1 and 2 above were in conformance with regulations and rules therefore as required in the current manual of survey instructions of the United States Department of the Interior, Bureau of Land Management or by a decree of a Court of Law and/or that the corner points mentioned in lines 3, 4 and 5 above were in conformance with the rules of the Michigan Board of Land Surveyors or by a Decree of a Court of Law; established, re-established, monumented, re-monumented, recovered, found as expressed below:

**NOTE: Not more than 4 corners, all in the same town and range, may be recorded on this certificate.**

A. Description of original monument and accessories and/or subsequent restoration:

None


B. Description of corner evidence found and/or method applied in restoring or reestablishing corner:

B-1: N 1/4 corner, Section 6: Found 1 1/4" i.d., 1 3/4" O.D. galvanized iron pipe 27" long fitting witnesses of record

C. Description of monument for corner and accessories established to perpetuate locating the position of the corner:

B-1: N 1/4 corner, Section 6: 1 1/4" i.d., 1 3/4" O.D. galvanized iron pipe 27" long accepted by Leelanau County Remonumentation Peer Group November 29, 1993, and replaced with a 3/4" i.d. galvanized iron pipe 3' long with a brass cap.

Fence post in N-S fenceline, N 70 E, 3.11'  
10" red pine - S 45 W, 49.22'  
7" spruce - S 38 E, 25.17'  
7" spruce - N 45 E, 21.25'

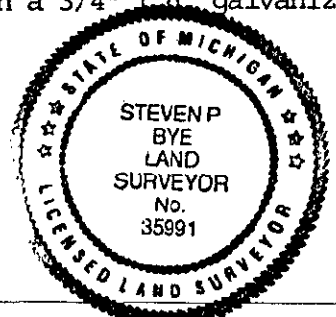

Signed by Steven P. Bye  
Surveyor's Michigan License No. 35991

Date 12-20-93