

**SURVEY &
REMONUMENTATION**

1993

COMMISSION

**LAND CORNER RECORDATION CERTIFICATE
Filing Requirement of Act 74, Mich. P.A. 1970**

STATE OF MICHIGAN
COUNTY OF LEELANAU
RECEIVED FOR RECORD

1993 DEC 28 PM 4: 24

Barbara Hirt
REGISTER OF DEEDS

FILE #321

LIBER 2 PAGE 18

For corners in
Leelanau

(County)

Located In:

Corner Code =#

1. Public Land Survey	T <u>28N</u> R <u>11W</u>	<u>B-3</u>
	T _____ R _____	_____
	T _____ R _____	_____
	T _____ R _____	_____
2. Property Controlling in Section	S _____ T _____ R _____	_____
	S _____ T _____ R _____	_____
3. Miscellaneous Property in Sec.	S _____ T _____ R _____	_____
	S _____ T _____ R _____	_____

Register of Deeds Stamp & File Number

4. Lot No. _____, Recorded Plat _____
5. Private Claims _____

A	B	C	D	E	F	G	H	I	J	K	L	M
2	6	5	4	3	2	1						
3												
4	7	8	9	10	11	12						
5												
6	18	17	16	15	14	13						
7												
8	19	20	21	22	23	24						
9												
10	30	29	28	27	26	25						
11												
12	31	32	33	34	35	36						
13												

I, Steven P. Bye, in a field survey on December 15, 19 93, do hereby certify that under requirements of P.A. 74, Michigan P.A. of 1970, the corner points mentioned in lines 1 and 2 above were in conformance with regulations and rules therefore as required in the current manual of survey instructions of the United States Department of the Interior, Bureau of Land Management or by a decree of a Court of Law and/or that the corner points mentioned in lines 3, 4 and 5 above were in conformance with the rules of the Michigan Board of Land Surveyors or by a Decree of a Court of Law; established, re-established, monumented, re-monumented, recovered, found as expressed below:

NOTE: Not more than 4 corners, all in the same town and range, may be recorded on this certificate.

A. Description of original monument and accessories and/or subsequent restoration:

B-3: S 1/4 corner, Section 6: G.L.O. "Set 1/4 section post"
Sugar 20 - N 13 W, 20 links
Sugar 12, S 36 W, 11 links


B. Description of corner evidence found and/or method applied in restoring or reestablishing corner:

B-3: S 1/4 corner, Section 6: Found 1/2" iron rod with cap #13026 at corner of fences West, North & East fitting 30" maple witness of record.

C. Description of monument for corner and accessories established to perpetuate locating the position of the corner:

B-3: S 1/4 corner, Section 6: 1/2" iron rod with cap #13026 accepted by the Leelanau County Remonumentation peer Group, November 29, 1993, and replaced with a 3/4" i.d galvanized iron pipe 3' long with a brass cap.

- 40" Maple - N 35 E, 105.82'
- 3" Maple (trip.) - N 87 E, 135.40'
- 7" Cherry - N 53 W, 179.33'
- 2" Maple - N 34 W, 66.08'

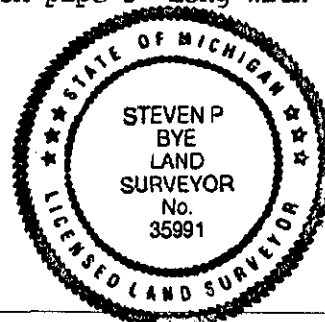

Signed by *Steven P. Bye*
Surveyor's Michigan License No. 35991

Date 12-22-93