

1993

COMMISSION

STATE OF MICHIGAN
COUNTY OF LEELANAU
RECEIVED FOR RECORD

1993 DEC 28 PM 4: 27

LAND CORNER RECORDATION CERTIFICATE
Filing Requirement of Act 74, Mich. P.A. 1970

Barbara Hirt
REGISTER OF DEEDS

For corners in
Leelanau
(County)

Located In: Corner Code #

- 1. Public Land Survey T 28N R 11W C-3
- T _____ R _____
- T _____ R _____
- T _____ R _____
- 2. Property Controlling S _____ T _____ R _____
- in Section S _____ T _____ R _____
- 3. Miscellaneous S _____ T _____ R _____
- Property in Sec. S _____ T _____ R _____

FILE #343

LIBER 2 PAGE 40

Register of Deeds Stamp & File Number

- 4. Lot No. _____, Recorded Plat _____
- 5. Private Claims _____

| | A | B | C | D | E | F | G | H | I | J | K | L | M |
|----|----|---|----|---|----|---|----|---|----|---|----|---|---|
| 2 | 6 | | 5 | | 4 | | 3 | | 2 | | 1 | | |
| 3 | | | ● | | | | | | | | | | |
| 4 | 7 | | 8 | | 9 | | 10 | | 11 | | 12 | | |
| 5 | | | | | | | | | | | | | |
| 6 | 18 | | 17 | | 16 | | 15 | | 14 | | 13 | | |
| 7 | | | | | | | | | | | | | |
| 8 | 19 | | 20 | | 21 | | 22 | | 23 | | 24 | | |
| 9 | | | | | | | | | | | | | |
| 10 | 30 | | 29 | | 28 | | 27 | | 26 | | 25 | | |
| 11 | | | | | | | | | | | | | |
| 12 | 31 | | 32 | | 33 | | 34 | | 35 | | 36 | | |
| 13 | | | | | | | | | | | | | |

I, Steven P. Bye, in a field survey on December 1, 19 93, do hereby certify that under requirements of P.A. 74, Michigan P.A. of 1970, the corner points mentioned in lines 1 and 2 above were in conformance with regulations and rules therefore as required in the current manual of survey instructions of the United States Department of the Interior, Bureau of Land Management or by a decree of a Court of Law and/or that the corner points mentioned in lines 3, 4 and 5 above were in conformance with the rules of the Michigan Board of Land Surveyors or by a Decree of a Court of Law; established, re-established, monumented, re-monumented, recovered, found as expressed below:

NOTE: Not more than 4 corners, all in the same town and range, may be recorded on this certificate.

A. Description of original monument and accessories and/or subsequent restoration:


C-3: SE corner Section 6: G.L.O. "Set post corner of Section 7 & 8"
Beech 16, S 16 E, 25 links
Hemlock 24, N 45 W, 16 links

B. Description of corner evidence found and/or method applied in restoring or reestablishing corner:

C-3: SE corner Section 6: 5/8" iron pipe found off the NW edge of a blue stone on West end of white & red pine double wind row on E-W occupation line. This is the same iron pipe as recorded by Wm. Batzer Jr. in Liber 37 of land corner records.

C. Description of monument for corner and accessories established to perpetuate locating the position of the corner:

C-3: SE corner of Section 6: 5/8" iron pipe accepted by the Leelanau County Remonumentation Peer Group, November 29, 1993. 5/8" iron pipe replaced with a 3/4" i.d. galvanized iron pipe, 3' long with a brass cap.

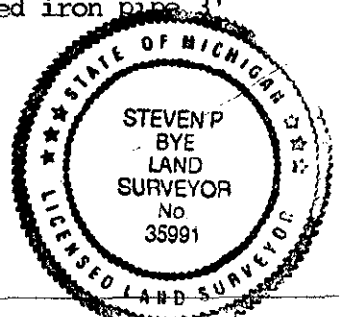

Signed by Steven P. Bye
Surveyor's Michigan License No. 35991

Date 12-20-93

40