

**SURVEY &
REMONUMENTATION**

APR 28 1995

COMMISSION

LAND CORNER RECORDATION CERTIFICATE
Filing Requirement of Act 74, Mich. P.A. 1970

STATE OF MICHIGAN
COUNTY OF LEELANAU
RECEIVED FOR RECORD

1994 DEC 12 PM 1:41

Barbara Kirt
REGISTER OF DEEDS

For corners in
Leelanau
(County)

Located In: Corner Code ≠#

- | | | |
|------------------------------------|---------------------------|------------|
| 1. Public Land Survey | T <u>28N</u> R <u>11W</u> | <u>E-3</u> |
| | T _____ R _____ | _____ |
| | T _____ R _____ | _____ |
| | T _____ R _____ | _____ |
| 2. Property Controlling in Section | S _____ T _____ R _____ | _____ |
| | S _____ T _____ R _____ | _____ |
| 3. Miscellaneous Property in Sec. | S _____ T _____ R _____ | _____ |
| | S _____ T _____ R _____ | _____ |

#360

LIBER 2 PAGE 57

Register of Deeds Stamp & File Number

4. Lot No. _____, Recorded Plat _____
5. Private Claims _____

A	B	C	D	E	F	G	H	I	J	K	L	M
2	6	5	4	3	2	1						
3												
4	7	8	9	10	11	12						
5												
6	18	17	16	15	14	13						
7												
8	19	20	21	22	23	24						
9												
10	30	29	28	27	26	25						
11												
12	31	32	33	34	35	36						
13												

I, Steven P. Bye, in a field survey on November 18, 19 94, do hereby certify that under requirements of P.A. 74, Michigan P.A. of 1970, the corner points mentioned in lines 1 and 2 above were in conformance with regulations and rules therefore as required in the current manual of survey instructions of the United States Department of the Interior, Bureau of Land Management or by a decree of a Court of Law and/or that the corner points mentioned in lines 3, 4 and 5 above were in conformance with the rules of the Michigan Board of Land Surveyors or by a Decree of a Court of Law; established, re-established, monumented, re-monumented, recovered, found as expressed below:

NOTE: Not more than 4 corners, all in the same town and range, may be recorded on this certificate.

A. Description of original monument and accessories and/or subsequent restoration:

E-3: Southeast corner of Section 5
Government notes, September 5, 1850 "set post corner to Sections 4,5,8 & 9"
Beech 18 - S 47 E, 29 links
Beech 16 - S 31 W, 54 links


B. Description of corner evidence found and/or method applied in restoring or reestablishing corner:

E-3: Southeast corner of Section 5:
1" diameter iron bar used by numerous surveyors and traced to Brehmer, July 1944 (iron bar in stones).
Record witnesses:
14" white pine - S 78 W, 11.50'
6" maple - S 87 E, 61.51'
Southeast corner of house foundation - S 50 W, 64.82'

APPROVED LAND CORNER
P.A. 345 OF 1990
LEELANAU COUNTY
DATE: 5-25-94
COUNTY REP. [Signature]

C. Description of monument for corner and accessories established to perpetuate locating the position of the corner:

E-3: Southeast corner of Section 5
1" diameter iron bar accepted by the Leelanau County Remonumentation Peer Review Group, May 25, 1994, and replaced with a 3/4" i.d. galvanized iron pipe 3' long with a brass cap.
14" white pine - S 78 W, 11.50'
Southeast corner of house foundation - S 50 W, 64.82'
Double 6" E 9" oak - S 89 E, 26.41'
12" chestnut - N 32 W, 31.30'

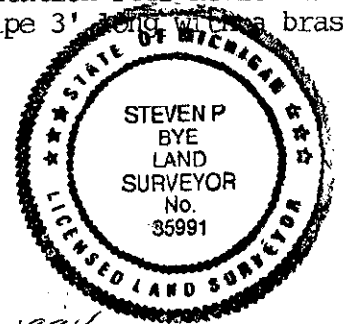

Signed by [Signature: Steven P. Bye] Date December 01, 1994
Surveyor's Michigan License No. 35991