

**SURVEY &  
REMONUMENTATION**

**MAR 04 1999**

**LAND CORNER RECORDATION CERTIFICATE  
Filing Requirement of Act 74, Mich. P.A. 1970**

For corners in **SECTION**

<u>Leelanau</u> <small>(County)</small>	Located In:	Corner Code #
1. Public Land Survey	<u>T 28NR 11W</u>	<u>E-7(Elmwood Twp.)</u>
	T ___ R ___	_____
	T ___ R ___	_____
	T ___ R ___	_____
2. Property Controlling in Section	S ___ T ___ R ___	_____
	S ___ T ___ R ___	_____
3. Miscellaneous Property in Sec.	S ___ T ___ R ___	_____
	S ___ T ___ R ___	_____

Barbara Kirt 12/31/98  
Leelanau Res of Deeds 9:49 am  
BJK Fee: 9.00  
04B00002 P0277 Page 1 of 1


#580

**Register of Deeds Stamp & File Number**

4. Lot No. \_\_\_\_\_, Recorded Plat \_\_\_\_\_  
5. Private Claims \_\_\_\_\_

I, Victoria A. Brown, in a field survey on December 14, 1998 do hereby state that under requirements of P.A. 74, Michigan P.A. of 1970, the corner points mentioned in lines 1 and 2 above were in conformance with regulations and rules therefore as required in the current manual of survey instructions of the United States Department of the Interior, Bureau of Land Management or by a decree of a Court of Law and for that the corner points mentioned in lines 3, 4 and 5 above were in conformance with the rules of the Michigan Board of Land Surveyors or by a Decree of a Court of Law; established, re-established, monumented, recovered, found as expressed below:

**NOTE: Not more than 2 corners, all in the same town and range, may be recorded on this certificate.**

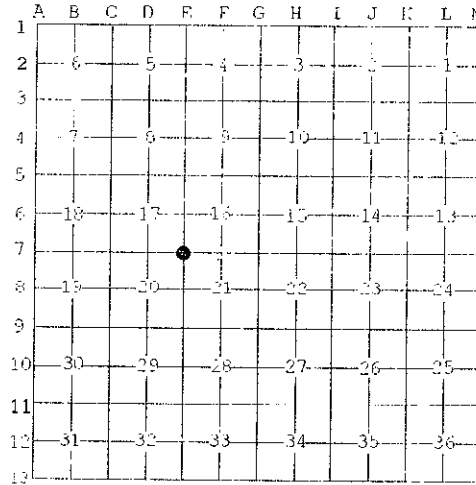

A. Description of original monument and accessories and/or subsequent restoration:  
E-7: Southeast corner of Section 17  
G.L.O. notes: Set post corner of Sections 16, 17, 20 & 21.

9" Beech S13°W 5 links  
12" Beech S70°E 45 links

**APPROVED LAND CORNER  
P.A. 345 OF 1990  
LEELANAU COUNTY**

DATE: 12-16-98  
COUNTY REP. [Signature]

B. Description of corner evidence found and/or method applied in restoring or reestablishing corner:  
E-7: Southeast corner of Section 17.


Found iron pipe 0.5' North of fence corner South, East and West (H.H. Brehmer 1943). Found 1 1/2" iron pipe on fence North, East and West (Mitchell 1984).

Witnesses:  
N85°W 6" Scotch Pine 46.88' on slope  
N40°E 8" Scotch Pine 26.35'  
N25°E 3" White Pine 31.2'

C. Description of monument for corner and accessories established to perpetuate locating the position of the corner:  
E-7: Southeast corner of Section 17

Found 1 1/2" iron pipe accepted as the best available evidence of the position of the the original corner by the Leelanau County Remonumentation Peer Review Group on December 16, 1998 and replaced with a 3/4" galvanized iron pipe, 3' long, with a brass cap.

Existing witnesses:	New Witnesses:
10" Scotch pine, N85°W 46.35'	6" Oak, N80°W 26.85'
10" Scotch pine, N40°E, 26.40'	
6" W. Pine, N25°E, 31.60'	

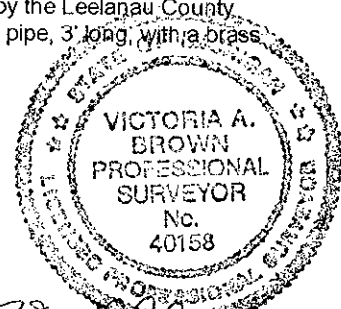

Signed by Victoria A. Brown  
Surveyor's Michigan License No. 40158

Date December 28, 1998