

**SURVEY & REMONUMENTATION**

LIBER **003** PAGE **586**

APR 27 1995

**COMMISSION**

**LAND CORNER RECORDATION CERTIFICATE**  
Filing Requirement of Act 74, Mich. P.A. 1970

For corners in  
**Grand Traverse**

(County)

Located in: Corner Code #

1. Public Land Survey	T <u>29N</u> R <u>10W</u>	<u>G-9</u>
	T _____ R _____	_____
	T _____ R _____	_____
	T _____ R _____	_____
2. Property Controlling in Section	S _____ T _____ R _____	_____
	S _____ T _____ R _____	_____
3. Miscellaneous Property in Sec.	S _____ T _____ R _____	_____
	S _____ T _____ R _____	_____

STATE OF MICHIGAN  
GRAND TRAVERSE COUNTY  
RECORDED

30 DEC 94 1:35 P.M.

KARON ANDERSON  
REGISTER OF DEEDS

Register of Deeds Stamp & File Number

4. Lot No. \_\_\_\_\_, Recorded Plat \_\_\_\_\_  
5. Private Claims \_\_\_\_\_

I, Garth D. Stowe, in a field survey on October 13, 19 94, do hereby certify that under requirements of P.A. 74, Michigan P.A. of 1970, the corner points mentioned in lines 1 and 2 above were in conformance with regulations and rules therefore as required in the current manual of survey instructions of the United States Department of the Interior, Bureau of Land Management or by a decree of a Court of Law and/or that the corner points mentioned in lines 3, 4 and 5 above were in conformance with the rules of the Michigan Board of Land Surveyors or by a Decree of a Court of Law; established, re-established, monumented, re-monumented, recovered, found as expressed below:

**NOTE: Not more than 4 corners, all in the same town and range, may be recorded on this certificate.**

A	B	C	D	E	F	G	H	I	J	K	L	M
2	6	5	4	3	2							
3												
4	7	8	9	10	11	12						
5												
6	18	17	16	15	14	13						
7												
8	19	20	21	22	23	24						
9												
10	30	29	28	27	26	25						
11												
12	31	32	33	34	35	36						
13												

A. Description of original monument and accessories and/or subsequent restoration:

G-9: Original G.L.O. notes and witnesses.  
County Surveyor records of 1903 filed in Liber 3, Pg. 216, Liber 2, Page 466 and Liber 3, Page 18.  
Iron set by Norton in 1957 by doubling over stone with "x" at 1/8 corner to West and South 1/4 corner. Set 1-1/4" iron pipe.  
LCR by DeLaMater, May 31, 1979, filed in Liber 02, Page 397.

B. Description of corner evidence found and/or method applied in restoring or reestablishing corner:


G-9: No physical evidence of original G.L.O. witnesses were found. Found 1-1/4" x 2.3' iron pipe 13.4 feet East of centerline of Seven Mile Road and replaced with Grand Traverse County monument. Corner is accepted as a careful and faithful re-establishment of the position of the original corner.

UNANIMOUSLY ACCEPTED BY THE  
GRAND TRAVERSE COUNTY PEER  
REVIEW GROUP AS THE OFFICIAL  
CORNER UNDER MICHIGAN PUBLIC  
ACT 345 OF 1990 AT A MEETING  
HELD ON 10-25-94  
*Robert F. Mitchell*  
ROBERT F. MITCHELL, P.S., CHAIRMAN

C. Description of monument for corner and accessories established to perpetuate locating the position of the corner:

G-9: Corner common to Sections 21, 22, 27 & 28, T.29N., R.10W.  
Perpetuated with 2-1/2" x 30" flanged bottom galvanized iron pipe with 3-1/4" brass cap stamped GRAND TRAVERSE COUNTY REMONUMENTATION.  
S54°E 25.30' 8" Maple  
N85°E 14.14' Power Pole  
N82°W 42.76' Power Pole  
S58°W 76.15' 8" Scotch Pine

Corner approved by the Grand Traverse County Peer Review Group on 10-25-94.

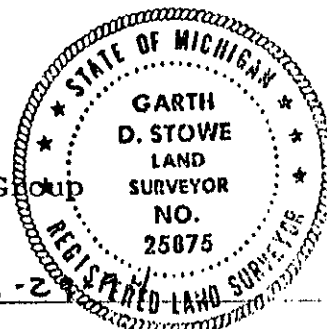

Signed by Garth D. Stowe 25875  
Surveyor's Michigan License No. \_\_\_\_\_

Date 12-2