SURVEY & REMONUMENTATION

1993

COMMISSION

STATE OF MICHIGAN
COUNTY OF LEELANAU
RECEIVED FOR RECORD

1993 DEC 28 PM 4: 26

Barbara Kist
REGISTER OF DEEDS

FILE #339

LIBER 2 PAGE 36

Register of Deeds Stamp & File Number

LAND CORNER RECORDATION CERTIFICATE

Filing Requirement of Act 74, Mich. P.A. 1970

For corners in Leelanau (County)

	Located In:	Corner Code ##
1. Public Land Survey	T 29N R 11W	B-1
	T ___ R ___	
	T ___ R ___	
	T ___ R ___	
2. Property Controlling	S ___ T ___ R ___	
in Section	S ___ T ___ R ___	
3. Miscellaneous	S ___ T ___ R ___	
Property in Sec.	S ___ T ___ R ___	

4. Lot No. _____, Recorded Plat _____
5. Private Claims _____

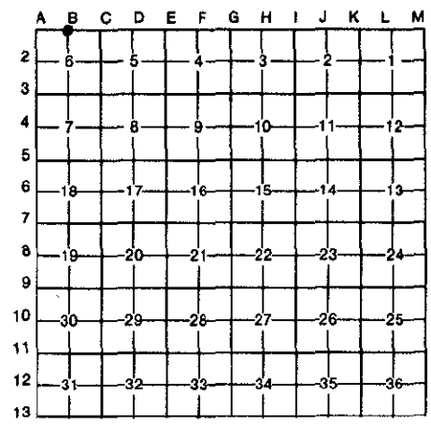

I, Steven P. Bye, in a field survey on December 12, 19 93, do hereby certify that under requirements of P.A. 74, Michigan P.A. of 1970, the corner points mentioned in lines 1 and 2 above were in conformance with regulations and rules therefore as required in the current manual of survey instructions of the United States Department of the Interior, Bureau of Land Management or by a decree of a Court of Law and/or that the corner points mentioned in lines 3, 4 and 5 above were in conformance with the rules of the Michigan Board of Land Surveyors or by a Decree of a Court of Law; established, re-established, monumented, re-monumented, recovered, found as expressed below:

NOTE: Not more than 4 corners, all in the same town and range, may be recorded on this certificate.

A. Description of original monument and accessories and/or subsequent restoration:

B-1: N 1/4 corner Section 6: G.L.O. "Set 1/4 section post"
Beech 16 N 05 W, 42 links
Sugar 14 S 38 E, 16 links

B. Description of corner evidence found and/or method applied in restoring or reestablishing corner:

B-1: N 1/4 corner Section 6: Railroad spike (found) in centerline Kohler Road that has been utilized by many surveyors.

C. Description of monument for corner and accessories established to perpetuate locating the position of the corner:

B-1: N 1/4 corner Section 6: Railroad spike accepted by Leelanau County Remonumentaion Peer Review Group, November 29, 1993. Railroad spike replaced with a 3/4" i.d. galvanized pipe 3' long with a brass cap.

Power pole - North 36.00' (record)
Fence post - S 60 W, 69.80' (record)
Power pole - South 198.00' (record)

8" Elm S 78 W 122.79' (set spike)

STATE OF MICHIGAN
STEVEN P. BYE
LAND SURVEYOR
No. 35991
LICENSED LAND SURVEYOR

Signed by Steven P. Bye Date 12-20-93

Surveyor's Michigan License No. 35991

FORM APPROVED BY MICHIGAN STATE BOARD OF LAND SURVEYORS, JAN. 28, 1971
REVISED MAY 14, 1975
REVISED JAN., 1983