

1995 DEC 29 PM 2:09

LAND CORNER RECORDATION CERTIFICATE  
 Filing Requirement of Act 74, Mich. P.A. 1970

For corners in

Leelanau  
 (County)

Located in:

Corner Code #

- |                                    |                            |            |
|------------------------------------|----------------------------|------------|
| 1. Public Land Survey              | T <u>29</u> NR <u>11</u> W | <u>C-3</u> |
|                                    | T ___ R ___                | _____      |
|                                    | T ___ R ___                | _____      |
|                                    | T ___ R ___                | _____      |
| 2. Property Controlling in Section | S ___ T ___ R ___          | _____      |
|                                    | S ___ T ___ R ___          | _____      |
| 3. Miscellaneous Property in Sec.  | S ___ T ___ R ___          | _____      |
|                                    | S ___ T ___ R ___          | _____      |

*Barbara Kirt*  
 REGISTER OF DEEDS

# 424

LIBER 2 PAGE 121

Register of Deeds Stamp & File Number

4. Lot No. \_\_\_\_\_, Recorded Plat \_\_\_\_\_  
 5. Private Claims \_\_\_\_\_

I, Nicholas M. O'Non, in a field survey on Nov. 27, 1995 do hereby state that under requirements of P.A. 74, Michigan P.A. of 1970, the corner points mentioned in lines 1 and 2 above were in conformance with regulations and rules therefore as required in the current manual of survey instructions of the United States Department of the Interior, Bureau of Land Management or by a decree of a Court of Law and/or that the corner points mentioned in lines 3, 4 and 5 above were in conformance with the rules of the Michigan Board of Land Surveyors or by a Decree of a Court of Law; established, re-established, monumented, recovered, found as expressed below:

NOTE: Not more than 2 corners, all in the same town and range, may be recorded on this certificate.

|    |   |    |   |    |   |    |   |    |   |    |   |    |   |
|----|---|----|---|----|---|----|---|----|---|----|---|----|---|
| 1  | A | B  | C | D  | E | F  | G | H  | I | J  | K | L  | M |
| 2  |   | 6  |   | 5  |   | 4  |   | 3  |   | 2  |   | 1  |   |
| 3  |   |    | ● |    |   |    |   |    |   |    |   |    |   |
| 4  |   | 7  |   | 8  |   | 9  |   | 10 |   | 11 |   | 12 |   |
| 5  |   |    |   |    |   |    |   |    |   |    |   |    |   |
| 6  |   | 18 |   | 17 |   | 16 |   | 15 |   | 14 |   | 13 |   |
| 7  |   |    |   |    |   |    |   |    |   |    |   |    |   |
| 8  |   | 19 |   | 20 |   | 21 |   | 22 |   | 23 |   | 24 |   |
| 9  |   |    |   |    |   |    |   |    |   |    |   |    |   |
| 10 |   | 30 |   | 29 |   | 28 |   | 27 |   | 26 |   | 25 |   |
| 11 |   |    |   |    |   |    |   |    |   |    |   |    |   |
| 12 |   | 31 |   | 32 |   | 33 |   | 34 |   | 35 |   | 36 |   |
| 13 |   |    |   |    |   |    |   |    |   |    |   |    |   |

A. Description of original monument and accessories and/or subsequent restoration:

C-3: Section Corner Common to Sections 5, 6, 7 and 8.  
 G.L.O. Notes: Set Post Corner to Sections 5, 6, 7 and 8,  
 per Orange Risdon Survey, October 22, 1850.  
 Sugar 18", N 80° W, 61 Links  
 Sugar 20", S 51° E, 31 Links

APPROVED LAND CORNER  
 P.A. 345 OF 1990  
 LEELANAU COUNTY

DATE: 7-12-95


COUNTY REP. N.M. O'N

B. Description of corner evidence found and/or method applied in restoring or reestablishing corner:

C-3: Section Corner Common to Sections 5, 6, 7 and 8.  
 Found 5/8" iron rod with cap no. 19846, per T.H. Weinert Certificate of Survey dated August 20, 1974.  
 24" Maple, S 09° E, 142.30'  
 11" Maple, N 22° E, 73.55'  
 Power Pole w/transformer, S 42° W, 42.40'

C. Description of monument for corner and accessories established to perpetuate locating the position of the corner:

C-3: Section Corner Common to Sections 5, 6, 7 and 8.  
 Found 5/8" iron rod with cap no. 19846. Accepted as the best available evidence of the position of the original corner by the Leelanau County Peer Review Group July 12, 1995. Replaced with 3/4" by 3.0' long galvanized iron pipe with stamped brass cap.  
 20" Maple, S 48° W, 46.16'  
 22" Maple, S 85° W, 25.67'  
 Twin 5"&7" Maple, S 20° W, 29.20'  
 Power Pole, S 12° E, 65.29'

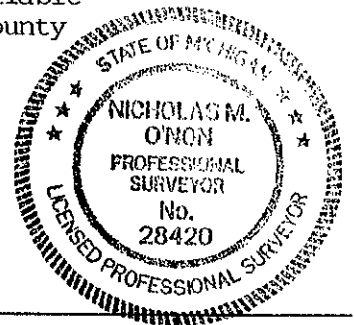

Signed by Nicholas M. O'Non  
 Surveyor's Michigan License No. 28420

Date 12-29-95