

MAY 18 1997

LAND CORNER RECORDATION CERTIFICATE
Filing Requirement of Act 74, Mich. P.A. 1970


Barbara Kirt 01/08/97
Leelanau Reg of Deeds 2:30 pm
BJK Fee: 9.00
04800002 P0158 Page 1 of 1

For corners in <u>Leelanau</u> (County)	Located In:	Corner Code #
1. Public Land Survey	T <u>29N</u> R <u>11W</u>	<u>D-3</u>
	T _____ R _____	_____
	T _____ R _____	_____
	T _____ R _____	_____
2. Property Controlling in Section	S _____ T _____ R _____	_____
	S _____ T _____ R _____	_____
3. Miscellaneous Property in Section	S _____ T _____ R _____	_____
	S _____ T _____ R _____	_____

#461

Register of Deeds Stamp & File Number

4. Lot No. _____, Recorded Plat _____
5. Private Claims _____

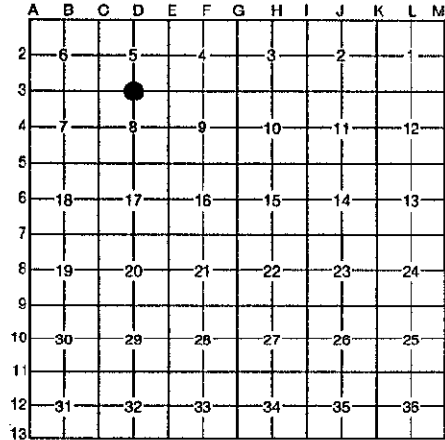

I, Steven P. Rye, in a field survey on September 27, 1996, do hereby certify that under requirements of P.A. 74, Michigan P.A. of 1970, the corner points mentioned in lines 1 and 2 above were in conformance with regulations and rules therefore as required in the current manual of survey instructions of the United States Department of the Interior, Bureau of Land Management or by a decree of a Court of Law and/or that the corner points mentioned in lines 3, 4 and 5 above were in conformance with the rules of the Michigan Board of Professional Surveyors or by a Decree of a Court of Law; established, re-established, monumented, re-monumented, recovered, found as expressed below:

NOTE: Not more than 4 corners, all in the same town and range, may be recorded on this certificate.

A. Description of original monument and accessories and/or subsequent restoration:

D-3: South 1/4 corner Section 5
G.L.O. notes
"Set 1/4 Section Post"
Sugar 14 N62E 19 links
Do. 16 S64W 39 links

APPROVED LAND CORNER
P.A. 345 OF 1990
LEELANAU COUNTY
DATE: 10-23-96
COUNTY REP. N.M. O'Non

B. Description of corner evidence found and/or method applied in restoring or reestablishing corner:

D-3: South 1/4 corner Section 5
County Surveyor notes: Corner Fence post at corner. On fence lines (North & South) and (East & West)).
Iron bar set in 1974 by T. Weinert per survey dated 08/20/74. - not at fence corner.
1/2" Rerod with cap #28420 set at intersection of N-S & E-W fence lines (per Brehmer survey) by N: O'Non survey dated June 11, 1987.
Mitchell (1991) filed Act 74 on 1/2" rerod with cap #28420.

C. Description of monument for corner and accessories established to perpetuate locating the position of the corner:

D-3: South 1/4 corner Section 5
1/2" Rerod with cap #28420 is accepted as the best available evidence of the position of the original corner by the Leelanau County Remonumentation Peer Review Group, October 23, 1996, and replaced with a 3/4" i.d. galvanized iron pipe 3' long with a brass cap and protective monument box.

- Witnesses:
- 10" Maple N05°E 21.66'
 - 8" Maple N47°W 36.05'
 - 16" Maple S20°W 27.25'
 - P. Pole S45°W 1.45'
 - 5/8" rerod N49°E 7.46'

Signed by Steven P. Rye Date 12/26/96

Surveyor's Michigan License No. 35991

