

1993

COMMISSION

STATE OF MICHIGAN  
COUNTY OF LEELANAU  
RECEIVED FOR RECORD

1993 DEC 28 PM 4: 23

LAND CORNER RECORDATION CERTIFICATE  
Filing Requirement of Act 74, Mich. P.A. 1970

For corners in

Leelanau

(County)

Located In:

Corner Code #

- |                                    |                           |            |
|------------------------------------|---------------------------|------------|
| 1. Public Land Survey              | T <u>29N</u> R <u>11W</u> | <u>E-1</u> |
|                                    | T _____ R _____           | _____      |
|                                    | T _____ R _____           | _____      |
|                                    | T _____ R _____           | _____      |
| 2. Property Controlling in Section | S _____ T _____ R _____   | _____      |
|                                    | S _____ T _____ R _____   | _____      |
| 3. Miscellaneous Property in Sec.  | S _____ T _____ R _____   | _____      |
|                                    | S _____ T _____ R _____   | _____      |

*Barbara Hirt*  
REGISTER OF DEEDS

FILE #3043

LIBER 2 PAGE 1

Register of Deeds Stamp & File Number

4. Lot No. \_\_\_\_\_, Recorded Plat \_\_\_\_\_  
5. Private Claims \_\_\_\_\_

	A	B	C	D	E	F	G	H	I	J	K	L	M
2	6	5	4	3	2	1							
3													
4	7	8	9	10	11	12							
5													
6	18	17	16	15	14	13							
7													
8	19	20	21	22	23	24							
9													
10	30	29	28	27	26	25							
11													
12	31	32	33	34	35	36							

I, Howard C. Walker, in a field survey on December 20, 19 93, do hereby certify that under requirements of P.A. 74, Michigan P.A. of 1970, the corner points mentioned in lines 1 and 2 above were in conformance with regulations and rules therefore as required in the current manual of survey instructions of the United States Department of the Interior, Bureau of Land Management or by a decree of a Court of Law and/or that the corner points mentioned in lines 3, 4 and 5 above were in conformance with the rules of the Michigan Board of Land Surveyors or by a Decree of a Court of Law; established, re-established, monumented, re-monumented, recovered, found as expressed below:

**NOTE: Not more than 4 corners, all in the same town and range, may be recorded on this certificate.**

A. Description of original monument and accessories and/or subsequent restoration:

E-1: NW corner, Section 4: County surveyor notes: "Concrete monument 33.0' West of corner" Liber 2, Page 134.

B. Description of corner evidence found and/or method applied in restoring or reestablishing corner:

E-1: NE corner, Section 4: Found 1/2" iron rod with cap in monument box.

Witnesses:


- 14" White pine - East 37.97'
- Power pole - S 29 W, 59.12'
- 16" White pine - N 41 W, 58.85'
- 4" Square concrete monument - N 84 W, 33.11'

C. Description of monument for corner and accessories established to perpetuate locating the position of the corner:

E-1: NE corner, Section 4: 1/2" iron rod in monument box accepted by the Leelanau County Remonumentation Peer Group, December 9, 1993, and replaced with a 3/4" i.d. galvanized iron pipe 3' long with a brass cap.

Witnesses:

- 14" White pine - East 37.97'
- Power pole - S 29 W, 59.12'
- 16" White pine - N 41 W, 58.85'
- 4" Square concrete monument - N 84 W, 33.11'

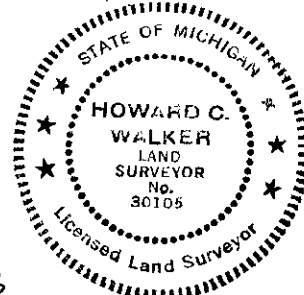

Signed by Howard C. Walker

Date 12-27-93

Surveyor's Michigan License No. 30105