

SURVEY & REMONUMENTATION COMMISSION
APR 10 1995

LAND CORNER RECORDATION CERTIFICATE
 Filing Requirement of Act 74, Mich. P.A. 1970

STATE OF MICHIGAN
 COUNTY OF LEELANAU
 RECEIVED FOR RECORD

1994 DEC 30 AM 10:40

For corners in

Leelanau
 (County)

Located In:

Corner Code =#

1. Public Land Survey	T 29N R 11W	E-11
	T _____ R _____	_____
	T _____ R _____	_____
	T _____ R _____	_____
2. Property Controlling in Section	S _____ T _____ R _____	_____
	S _____ T _____ R _____	_____
3. Miscellaneous Property in Sec.	S _____ T _____ R _____	_____
	S _____ T _____ R _____	_____

Barbara Kirt
 REGISTER OF DEEDS

#395

LIBER 2 PAGE 92

Register of Deeds Stamp & File Number

4. Lot No. _____, Recorded Plat _____
 5. Private Claims _____

I, Steven P. Bye, in a field survey on November 22, 19 94, do hereby certify that under requirements of P.A. 74, Michigan P.A. of 1970, the corner points mentioned in lines 1 and 2 above were in conformance with regulations and rules therefore as required in the current manual of survey instructions of the United States Department of the Interior, Bureau of Land Management or by a decree of a Court of Law and/or that the corner points mentioned in lines 3, 4 and 5 above were in conformance with the rules of the Michigan Board of Land Surveyors or by a Decree of a Court of Law; established, re-established, monumented, re-monumented, recovered, found as expressed below:

NOTE: Not more than 4 corners, all in the same town and range, may be recorded on this certificate.

	A	B	C	D	E	F	G	H	I	J	K	L	M
2	6		5		4		3		2		1		
3													
4	7		8		9		10		11		12		
5													
6	18		17		16		15		14		13		
7													
8	19		20		21		22		23		24		
9													
10	30		29		28		27		26		25		
11													
12	31		32		33		34		35		36		
13													

A. Description of original monument and accessories and/or subsequent restoration:

E-11: Northeast corner of Section 32
 G.L.O. notes by Orange Risdon, 1850
 "Set post corner to Sections 28,29,32 & 33"
 Elm 10 - N 21 W, 37 links
 Hemlock 24 - S 36 W, 7 links
 County surveyor notes: Iron buggy axle, 20" oak - N 43 W, 18.15'; 14" ash - S 50 E, 13.81', State Highway Department: 1937. Triple 4" elm SSE, 17.01'
 Iron pipe found by Brehmer, 1951.


B. Description of corner evidence found and/or method applied in restoring or reestablishing corner:

E-11: Northeast corner of Section 32
 Re-established by Brehmer - survey dated May 29, 1951, shows iron pipe at corner. Subsequently used by numerous surveyors.
 Record witnesses:
 Oak stump 20" - N 43 W, 17.77'
 Ash 14" - S 50 E, 13.75'
 Triple elm 4" - S 05 E, 17.78'

APPROVED LAND CORNER
 P.A. 345 OF 1990
 LEELANAU COUNTY
 DATE: 7-28-94
 COUNTY REP. M. M. O'Neil

C. Description of monument for corner and accessories established to perpetuate locating the position of the corner:

E-11: Northeast corner of Section 32
 1/2" iron pipe accepted by the Leelanau County Remonumentation Peer Review Group, July 28, 1994, and replaced with a 3/4" i.d. galvanized iron pipe 3' long with a brass cap and protective monument box.
 Witnesses:
 23" Basswood - S 43 E, 13.81'
 7" Ironwood - North 15.62'
 8" Double ironwood - South 17.94'
 20" Beech - N 68 W, 21.38'

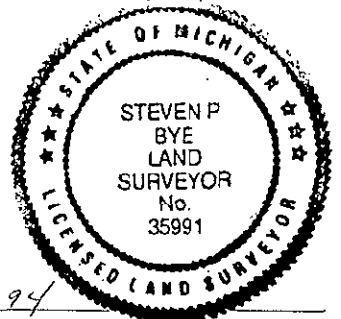

Signed by Steven P. Bye

Date December 16, 1994

Surveyor's Michigan License No. 35991

395