

1993

COMMISSION

LAND CORNER RECORDATION CERTIFICATE  
Filing Requirement of Act 74, Mich. P.A. 1970

STATE OF MICHIGAN  
COUNTY OF LEELANAU  
RECEIVED FOR RECORD  
1993 DEC 28 PM 4: 23

*Barbara Kirt*  
REGISTER OF DEEDS

FILE #305

LIBER 2 PAGE 2

Register of Deeds Stamp & File Number

For corners in  
Leelanau

(County)

Located In:

Corner Code #

- 1. Public Land Survey            T 29N R 11W        G-1
- T \_\_\_\_\_ R \_\_\_\_\_
- T \_\_\_\_\_ R \_\_\_\_\_
- T \_\_\_\_\_ R \_\_\_\_\_
- 2. Property Controlling        S \_\_\_\_\_ T \_\_\_\_\_ R \_\_\_\_\_
- in Section                    S \_\_\_\_\_ T \_\_\_\_\_ R \_\_\_\_\_
- 3. Miscellaneous                S \_\_\_\_\_ T \_\_\_\_\_ R \_\_\_\_\_
- Property in Sec.              S \_\_\_\_\_ T \_\_\_\_\_ R \_\_\_\_\_

- 4. Lot No. \_\_\_\_\_, Recorded Plat \_\_\_\_\_
- 5. Private Claims \_\_\_\_\_

I, Howard C. Walker, in a field survey on December 21, 19 93, do hereby certify that under requirements of P.A. 74, Michigan P.A. of 1970, the corner points mentioned in lines 1 and 2 above were in conformance with regulations and rules therefore as required in the current manual of survey instructions of the United States Department of the Interior, Bureau of Land Management or by a decree of a Court of Law and/or that the corner points mentioned in lines 3, 4 and 5 above were in conformance with the rules of the Michigan Board of Land Surveyors or by a Decree of a Court of Law; established, re-established, monumented, re-monumented, recovered, found as expressed below:

**NOTE: Not more than 4 corners, all in the same town and range, may be recorded on this certificate.**

	A	B	C	D	E	F	G	H	I	J	K	L	M
2	6		5		4		3		2		1		
3													
4	7		8		9		10		11		12		
5													
6	13		17		16		15		14		13		
7													
8	19		20		21		22		23		24		
9													
10	30		29		28		27		26		25		
11													
12	31		32		33		34		35		36		
13													

A. Description of original monument and accessories and/or subsequent restoration:

G-1: NE corner, Section 4: County surveyor notes: 1" steel shaft 8" maple - SE 35, 17.96', 8" maple, SE 15, 35.97', 3" maple SW 85, 19.72', State Highway Dept. 1937"

County Surveyor Notes (1903): "Stone"

B. Description of corner evidence found and/or method applied in restoring or reestablishing corner:


G-1: NE corner, Section 4: Found axle shaft next to West base of 18" maple used as fence corner.

C. Description of monument for corner and accessories established to perpetuate locating the position of the corner:

G-1: NE corner, Section 4: Axle shaft next to west base of 18" maple used as fence corner accepted by the Leelanau County Remonumentation Peer Group, December 9, 1993. SET CAP (METAL) OVER SHAFT

Witnesses:

- 16" maple - West, 19.73'
- 13" maple - S 04 30" E, 36.00'
- 15" maple - S 42 E, 14.31'
- Power pole - N 59 W, 57.33'

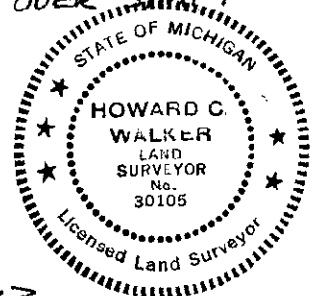

Signed by Howard C. Walker

Date 12-27-93

Surveyor's Michigan License No. 30105