LAND CORNER RECORDATION CERTIFICATE

Filing Requirement of Act 74, Mich. P.A. 1970

For corners in
GRAND TRAVERSE
(County)

	Located In:	Corner Code ##
1. Public Land Survey	T 30N R 10W	K-9
	T ___ R ___	
	T ___ R ___	
	T ___ R ___	
2. Property Controlling	S 23 T ___ R ___	9,13
in Section	S ___ T ___ R ___	
3. Miscellaneous	S ___ T ___ R ___	
Property in Sec.	S ___ T ___ R ___	

Register of Deeds Stamp & File Number

4. Lot No. _____ , Recorded Plat _____
5. Private Claims _____

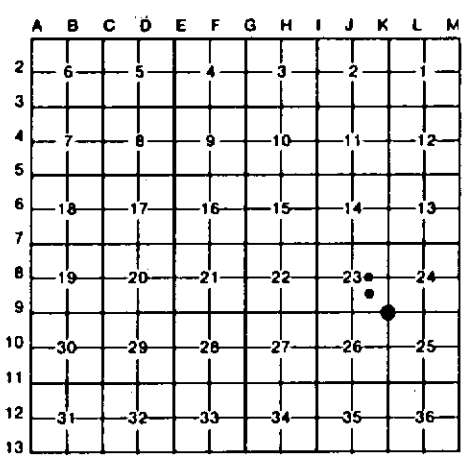

I, C.F.ROSER, in a field survey on 11-13, 19 90, do hereby certify that under requirements of P.A. 74, Michigan P.A. of 1970, the corner points mentioned in lines 1 and 2 above were in conformance with regulations and rules therefore as required in the current manual of survey instructions of the United States Department of the Interior, Bureau of Land Management or by a decree of a Court of Law and/or that the corner points mentioned in lines 3, 4 and 5 above were in conformance with the rules of the Michigan Board of Land Surveyors or by a Decree of a Court of Law; established, re-established, monumented, re-monumented, recovered, found as expressed below:

NOTE: Not more than 4 corners, all in the same town and range, may be recorded on this certificate.

A. Description of original monument and accessories and/or subsequent restoration:

K-9	9	13

B. Description of corner evidence found and/or method applied in restoring or reestablishing corner:

K-9	9	13
FD AND ACCEPTED CONC MON FOR SE COR SEC 23. COR ESTABLISHED BY GOURDIE FRASER AND ASSOC. INC IN 1977. COR IS IN LINE W/CTR OF FIELD DRIVE TO SOUTH & 9'± SOUTH OF E-W FIELD DRIVE.	FD & ACCEPTED CONC MON FOR NE COR OF NW1/4 OF SE1/4 OF SEC 23. COR SET BY MORTON-GOURDIE-MILLER & BATZER INC IN 1964. CTR E-W TRAIL IS 44' S.	ESTABLISHED CTR OF SE1/4 OF SEC 23 PER STANDARD BLM INSTRUCTIONS.

C. Description of monument for corner and accessories established to perpetuate locating the position of the corner:

K-9	9			13		
FD CONC MON. RAISED UP WITH 1" X 14" GALV PIPE W/LS CAP. SET CEDAR POST W/LOC TAG.	FD CONC MON; ADDED CED POST W/LOC TAG.			DROVE 5/8"x 34" REROD W/LS CAP & SET CEDAR POST W/LOC TAG.		
	9" W.BIRCH	N70°W	15.3'	6" MAPLE	N75°W	7.72'
	7" MAPLE	N85°E	6.5'	4" MAPLE	N30°E	2.94'
	4" MAPLE	S25°E	3.1'	14"TRIPLE ASH	S50°E	24.60'
NO AVAILABLE WITS COR FALLS IN OPEN FIELD	5" HEMLOCK	S40°W	7.4'	8" R.OAK	S10°W	27.02'

STATE OF MICHIGAN
CARL F. ROSER
LAND SURVEYOR
No. 12028
REGISTERED LAND SURVEYOR

Signed by Carl F. Roser 03-06-91 Date _____

Surveyor's Michigan License No. 12028

FORM APPROVED BY MICHIGAN STATE BOARD OF LAND SURVEYORS, JAN. 28, 1971
REVISED MAY 14, 1975
REVISED JAN., 1983