

LAND CORNER RECORDATION CERTIFICATE  
Filing Requirement of Act 74, Mich. P.A. 1970

4/5/95  
R.W. Craigh  
For corners in

Houghton (County) Located In: Corner Code #

1. Public Land Survey	147N R 37W.	A-10
	T R	
	T R	
	T R	
2. Property Controlling in Section	S T R	
	S T R	
3. Miscellaneous Property in Sec.	S T R	
	S T R	

REGISTER'S OFFICE  
Houghton County, Mich.  
Received for record the 25th day  
of April, A. D., 1995, at 11:00  
o'clock, A.M. and recorded in Vol. 3  
of Land Corner Page 217  
Richard L. Drahn  
Register

Register of Deeds Stamp & File Number

4. Lot No. \_\_\_\_\_, Recorded Plat \_\_\_\_\_  
5. Private Claims \_\_\_\_\_  
1/4 Corner, Sections 25 & 30; T.47N., R.37-38W.

I, Richard L. Drahn, in a field survey on December 21, 1994,  
do hereby certify that under requirements of P.A. 74, Michigan P.A. of 1970, the corner points mentioned  
in lines 1 and 2 above were in conformance with regulations and rules therefore as required in the  
current manual of survey instructions of the United States Department of the Interior, Bureau of Land  
Management or by a decree of a Court of Law and/or that the corner points mentioned in lines 3, 4 and 5  
above were in conformance with the rules of the Michigan Board of Land Surveyors or by a Decree of a  
Court of Law; established, re-established, monumented, re-monumented, recovered, found as  
expressed below:


	A	B	C	D	E	F	G	H	I	J	K	L	M
1													
2	6	5	4	3	2	1							
3													
4	7	8	9	10	11	12							
5													
6	16	17	18	15	14	13							
7													
8	19	20	21	22	23	24							
9													
10	30	29	28	27	26	25							
11													
12	31	32	33	34	35	36							
13													

NOTE: Not more than 4 corners, all in the same town and range, may be recorded  
on this certificate.

A. Description of original monument and accessories and/or subsequent restoration:  
Corner established by Austin Burt, U.S. Deputy Surveyor, in 1847. Original bearing trees:  
Sugar 12" S.70E. 29 links (19.14 feet)  
Sugar 14" N.22W. 31 links (20.46 feet)

B. Description of corner evidence found and/or method applied in restoring or reestablishing corner:  
No G.L.O. evidence remains. Corner position re-established on line between and equal  
distance from section corners 1/2 mile north and south.

SURVEY &  
REMONUMENTATION  
MAY 16 1997  
COMMISSION

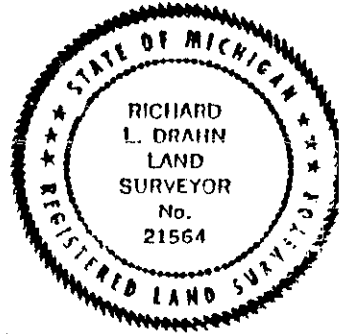

C. Description of monument for corner and accessories established to perpetuate locating the position of the corner:  
At the corner position I set a 2 1/2" diameter by 30" long aluminum monument with a 3 1/4"  
aluminum cap with magnet stamped to read: T.47N., R.37-38W. 1/4; S-25, S-30; 1994; R.L.S.  
21564 from which I established the following new biased and scribed bearing trees and/or  
objects:

12"	Basswood	N.70E.	15.27 feet
10"	Ironwood	N.10W.	28.27 feet
8"	Sugar Maple	S.10W.	7.49 feet
6'	Steel Rail	N.15W.	1.09 feet

Signed by Richard L. Drahn Date February 7, 1995  
Surveyor's Michigan License No. 21564