

LAND CORNER RECORDATION CERTIFICATE
Filing Requirement of Act 74, Mich. P.A. 1970

For corners in


<u>Houghton</u> (County)	Located In:	Corner Code #
1. Public Land Survey	T 47 N. R 37 W.	F-11
	T _____ R _____	_____
	T _____ R _____	_____
	T _____ R _____	_____
2. Property Controlling in Section	S _____ T _____ R _____	_____
	S _____ T _____ R _____	_____
3. Miscellaneous Property in Sec.	S _____ T _____ R _____	_____

REGISTER'S OFFICE
Houghton County, Mich. } ss.
Received for record the 21st day
of February A. D., 19 96, at 2:45
o'clock PM and recorded in Vol. 3
of Land Corner Records Page 325
Richard L. Drahn
Register

Register of Deeds Stamp & File Number

4. Lot No. _____, Recorded Plat _____
5. Private Claims _____
Quarter corner 28 & 33; T.47 N., R.37 W.

I, Richard L. Drahn in a field survey on May 17, 19 95,
do hereby certify that under requirements of P.A. 74, Michigan P.A. of 1970, the corner points mentioned
in lines 1 and 2 above were in conformance with regulations and rules therefore as required in the
current manual of survey instructions of the United States Department of the Interior, Bureau of Land
Management or by a decree of a Court of Law and/or that the corner points mentioned in lines 3, 4 and 5
above were in conformance with the rules of the Michigan Board of Land Surveyors or by a Decree of a
Court of Law; established, re-established, monumented, re-monumented, recovered, found as
expressed below:

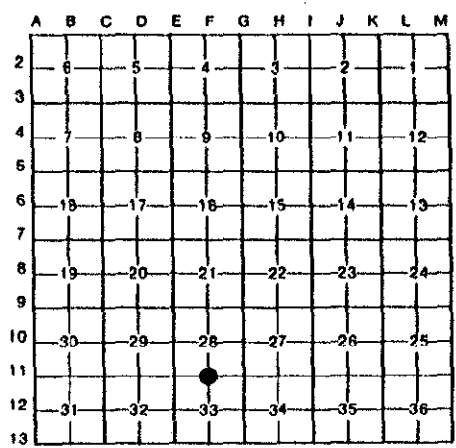

NOTE: Not more than 4 corners, all in the same town and range, may be recorded on this certificate.

A. Description of original monument and accessories and/or subsequent restoration:
Original corner established by E.C. Martin, Deputy Surveyor on August 25, 1851. Original bearing trees:

Y. Birch	12"	S.44 W.	3 links	(1.98 feet)
Hemlock	10"	N.50 E.	14 links	(9.24 feet)

Corner research records on file with Houghton county. (4/18/95)


B. Description of corner evidence found and/or method applied in restoring or reestablishing corner:
No evidence of original corner or bearing trees found. Corner re-established on line between and equal distance from, the southeast and southwest section corners of section 28; T.47 N., R.37 W.

A Keweenaw Lumber Co. Location Poster dated 5/10/73 bears S.75 W., 50.6'.

Survey &
REMONUMENTATION
MAY 16 1997
COMMISSION

C. Description of monument for corner and accessories established to perpetuate locating the position of the corner:
At the corner position I set a 2 1/2" x 30" long aluminum monument with a 3 1/4" aluminum cap, stamped to read: T.47 N., R.37 W.; 1/4; S-28, S-33; 1995: R.L.S. 21564. From which I established the following new blazed and scribed bearing trees:

7"	Aspen	N.62 W.	17.57 feet
10"	Aspen	N.51 E.	15.50 feet
4"	R. Maple	S.54 W.	23.50 feet
6'	Steel rail	N.12 W.	1.03 feet

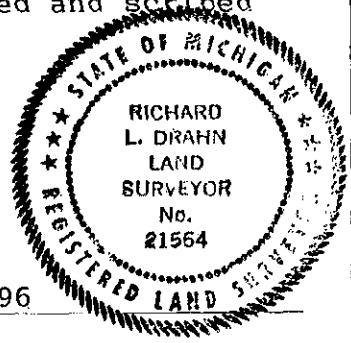

Signed by Richard L. Drahn Date February 26, 1996
Surveyor's Michigan License No. 21564