

LAND-CORNER RECORDATION CERTIFICATE
Filing Requirement of Act 74, Mich. P.A. 1970

For corners in

Houghton
(County)

Located In:

Corner Code #

- | | | | | | |
|------------------------------------|---|------------|---|--------------|-------|
| 1. Public Land Survey | T | <u>47N</u> | R | <u>37 W.</u> | G-12 |
| | T | _____ | R | _____ | _____ |
| | T | _____ | R | _____ | _____ |
| | T | _____ | R | _____ | _____ |
| 2. Property Controlling in Section | S | _____ | T | _____ | _____ |
| | S | _____ | T | _____ | _____ |
| 3. Miscellaneous Property in Sec. | S | _____ | T | _____ | _____ |
| | S | _____ | T | _____ | _____ |

REGISTER'S OFFICE
Houghton County, Mich. } ss.

Received for record the 21ST day
of October A. D., 1996, at 3:45
o'clock P. M. and recorded in Vol. 3
of Land Corner Records Page 323
Richard L. Drahn Register

Register of Deeds Stamp & File Number

4. Lot No. _____, Recorded Plat _____
5. Private Claims _____

Quarter corner 33 & 34; T.47 N., R.37 W.

I, Richard L. Drahn in a field survey on July 11, 1995, do hereby certify that under requirements of P.A. 74, Michigan P.A. of 1970, the corner points mentioned in lines 1 and 2 above were in conformance with regulations and rules therefore as required in the current manual of survey instructions of the United States Department of the Interior, Bureau of Land Management or by a decree of a Court of Law and/or that the corner points mentioned in lines 3, 4 and 5 above were in conformance with the rules of the Michigan Board of Land Surveyors or by a Decree of a Court of Law; established, re-established, monumented, re-monumented, recovered, found as expressed below:

NOTE: Not more than 4 corners, all in the same town and range, may be recorded on this certificate.

A. Description of original monument and accessories and/or subsequent restoration:

Original corner established by E.C. Martin, Deputy Surveyor on August 25, 1851. Original bearing trees:

Hemlock	18"	S.38 E.	19 links	(12.54 feet)
Sugar	8"	N.29 W.	15 links	(9.90 feet)

Corner research record on file with Houghton County. (4/18/95)

B. Description of corner evidence found and/or method applied in restoring or reestablishing corner:

No evidence of original corner or bearing trees found. Corner position re-established on line between and equal distance from the northwest and southwest section corners of section 34; T.47 N., R.37 W.

A Nordine Lumber Co. Location Poster recovered bearing S.75 E., 54.22 feet from the re-established corner location.


SURVEY &
MONUMENTATION

MAY 16 1997

C. Description of monument for corner and accessories established to perpetuate locating the position of the corner:

At the corner position I set a 2½" x 30" long aluminum monument with a 3½" aluminum cap, stamped to read: T.47 N., R.37 W.; ¼; S-33, S-34; 1995; R.L.S. 21564. From which I established the following new blazed and scribed bearing trees:

12"	Sugar Maple	N.15 W.	16.71 feet
6"	Sugar Maple	N.72 E.	9.03 feet
8"	Sugar Maple	S.45 W.	6.83 feet
6'	Steel rail	S.85 W.	0.66 feet

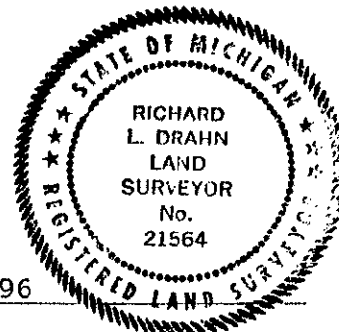

Signed by Richard L. Drahn

Date February 26, 1996

Surveyor's Michigan License No. 21564