

LAND CORNER RECORDATION CERTIFICATE
Filing Requirement of Act 74, Mich. P.A. 1970

For corners in HOUGHTON (County)

Located In: Corner Code #/

- 1. Public Land Survey T 47N R 37W K-10
2. Property Controlling In Section S T R
3. Miscellaneous Property In Sec. S T R

REGISTER'S OFFICE

Houghton County, Mich.
Received for record the 25th day of April, 1994, at 9:30 o'clock, P.M. and recorded in Vol. 7 Page 221
Register of Deeds Stamp & File Number

- 4. Lot No. Recorded Plat
5. Private Claims

1 Corner, Sections 25, 26; T.47N., R.37W.

I, Richard L. Drahn, in a field survey on December 21, 1993, do hereby certify that under requirements of P.A. 74, Michigan P.A. of 1970, the corner points mentioned in lines 1 and 2 above were in conformance with regulations and rules therefore as required in the current manual of survey instructions of the United States Department of the Interior, Bureau of Land Management or by a decree of a Court of Law and/or that the corner points mentioned in lines 3, 4 and 5 above were in conformance with the rules of the Michigan Board of Land Surveyors or by a Decree of a Court of Law; established, re-established, monumented, re-monumented, recovered, found as expressed below:

Grid table with columns A-M and rows 2-13. Contains numbers 1-36 in a grid pattern.

NOTE: Not more than 4 corners, all in the same town and range, may be recorded on this certificate.

A. Description of original monument and accessories and/or subsequent restoration: Corner established by E.C. Martin, U.S. Deputy Surveyor, on September 29, 1851. Original bearing trees:

- Y. Birch 8" S.18°W. 12 links (7.92 feet)
Y. Birch 12" N.62°E. 31 links (20.46 feet)


B. Description of corner evidence found and/or method applied in restoring or reestablishing corner:

Original corner and bearing trees destroyed by road construction. Re-established corner position by single proportion measure on line between the N.W. and the S.W. corners of Section 25.

SURVEY & MONUMENTATION

MAY 16 1997

COMMISSION

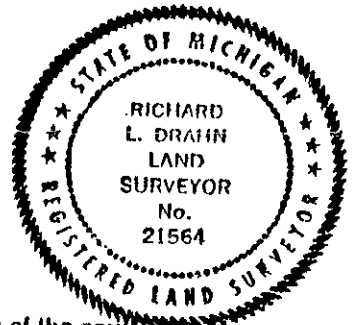

C. Description of monument for corner and accessories established to perpetuate locating the position of the corner: At the corner position and 6" below shoulder of a F.H. #16 I set a 2" diameter by 12" long concrete filled, galvanized iron pipe with a 3" brass cap stamped to read: T.47N., R.37W.; S.25, S.26; 1993; R.L.S. 21564: from which I established the following N.W. blazed and scribed bearing trees and reference objects:

- 10" Sugar Maple N.81°W. 72.46 feet
8" Yellow Birch N.45°W. 95.20 feet
10" Sugar Maple S.72°W. 70.23 feet

A 6' steel sign post bears West 66.85 feet.

A standard 30" long, aluminum R.M. with a 3 1/4" aluminum cap, stamped to indicate true corner position bears West, 65.89 feet.

Signed by Richard L. Drahn Date February 11, 1994

Surveyor's Michigan License No. 21564