

223

LAND CORNER RECORDATION CERTIFICATE  
Filing Requirement of Act 74, Mich. P.A. 1970

For corners in

Houghton  
(County)

Located in:

Corner Code #1

- 1. Public Land Survey T 47N R 37W Corner Code #1 K-12
- T R
- T R
- T R
- 2. Property Controlling S T R
- In Section S T R
- 3. Miscellaneous S T R
- Property In Sec. S T R

REGISTER'S OFFICE

Houghton County, Mich.

Received for record the 25<sup>th</sup> day  
of April, A. D., 1993, at 2:00  
o'clock, P. M., and recorded in Vol. 3  
of Final P.L.S., Page 223  
.....  
Register

Register of Deeds Stamp & File Number

- 4. Lot No. \_\_\_\_\_, Recorded Plat \_\_\_\_\_
- 5. Private Claims \_\_\_\_\_

1/4 Corner, Sections 35, 36; T.47N., R.36W.

I, Richard L. Drahn in a field survey on December 20, 1993, do hereby certify that under requirements of P.A. 74, Michigan P.A. of 1970, the corner points mentioned in lines 1 and 2 above were in conformance with regulations and rules therefore as required in the current manual of survey instructions of the United States Department of the Interior, Bureau of Land Management or by a decree of a Court of Law and/or that the corner points mentioned in lines 3, 4 and 5 above were in conformance with the rules of the Michigan Board of Land Surveyors or by a Decree of a Court of Law: established, re-established, monumented, re-monumented, recovered, found as expressed below:

NOTE: Not more than 4 corners, all in the same town and range, may be recorded on this certificate.

A. Description of original monument and accessories and/or subsequent restoration:

Corner falls in lake and was not established by original surveyor.

B. Description of corner evidence found and/or method applied in restoring or reestablishing corner:

Mathematical corner position falls in small lake, established witness corner on north shore of lake. Witness corner is 823.14' north of math point in lake.

	A	B	C	D	E	F	G	H	I	J	K	L	M
2	6	5	4	3	2	1							
3													
4	7	8	9	10	11	12							
5													
6	16	17	18	19	20	21	22	23	24				
7													
8	19	20	21	22	23	24							
9													
10	30	29	28	27	26	25							
11													
12	31	32	33	34	35	36							
13													

SURVEY &  
REMONUMENTATION

MAY 16 1997


COMMISSION

C. Description of monument for corner and accessories established to perpetuate locating the position of the corner:

At the corner position I set a standard 2" diameter by 30" long split base aluminum monument with a 3/4" aluminum cap stamped to read: T.47N., r.37W.; 1/4; W.C.; S.35; 5-36; South, 823.14 ft.; 1993; R.L.S. 21564; from which I established the following monumented, blazed and scribed bearing trees and/or reference objects:

- 10" Cedar N.80°W. 2.56 feet
- 10" Cedar N.16°W. 10.30 feet
- 10" Cedar S.48°W. 18.48 feet

A 6' steel sign post bears: S.80°E., 0.51 feet.

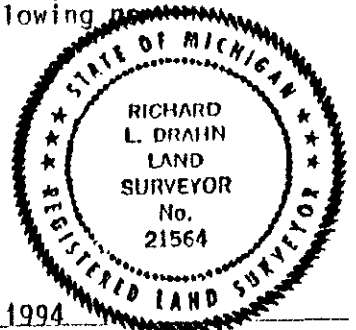

Signed by Richard L. Drahn

Date February 11, 1994

Surveyor's Michigan License No. 21564

U.S.F.S. X-21