

LAND CORNER RECORDATION CERTIFICATE  
Filing Requirement of Act 74, Mich. P.A. 1970

For corners in  
HOUGHTON & IRON  
(County)

Located in: Corner Code #1

1. Public Land Survey	T 47-46N R 37W	K-1 K-13
	T _____ R _____	_____
	T _____ R _____	_____
	T _____ R _____	_____
2. Properly Controlling In Section	S _____ T _____ R _____	_____
	S _____ T _____ R _____	_____
3. Miscellaneous Property In Sec.	S _____ T _____ R _____	_____
	S _____ T _____ R _____	_____

REGISTER'S OFFICE  
Houghton County, Mich.  
Received for record the 2:50 PM  
of February 15, A. D., 1994, at 2:50  
o'clock PM and recorded in Vol. 3  
of Final Record Page 217  
Richard L. Drahn Register  
Register of Deeds Stamp & File Number

4. Lot No. \_\_\_\_\_, Recorded Plat \_\_\_\_\_  
5. Private Claims \_\_\_\_\_

Section corner, Sections 35, 36, 1, 2; T.47-46N., R.37W.

I, Richard L. Drahn, in a field survey on December 6, 1993, do hereby certify that under requirements of P.A. 74, Michigan P.A. of 1970, the corner points mentioned in lines 1 and 2 above were in conformance with regulations and rules therefore as required in the current manual of survey instructions of the United States Department of the Interior, Bureau of Land Management or by a decree of a Court of Law and/or that the corner points mentioned in lines 3, 4 and 5 above were in conformance with the rules of the Michigan Board of Land Surveyors or by a Decree of a Court of Law; established, re-established, monumented, re-monumented, recovered, found as expressed below:

A	B	C	D	E	F	G	H	I	J	K	L	M
2	6	5	4	3	2	1						
3												
4	7	8	9	10	11	12						
5												
6	16	17	18	15	14	13						
7												
8	19	20	21	22	23	24						
9												
10	30	29	26	27	28	25						
11												
12	31	32	33	34	35	36						
13												

NOTE: Not more than 4 corners, all in the same town and range, may be recorded on this certificate.

A. Description of original monument and accessories and/or subsequent restoration:  
Corner established by John Burt, U.S. Deputy Surveyor, on June 15, 1847.  
Original bearing trees:

Hemlock	12"	N.16°E.	21 links	(13.86 feet)
Hemlock	20"	N.22°W.	20 links	(13.20 feet)
Maple	18"	S.16°E.	38 links	(25.08 feet)
Hemlock	24"	S.57°W.	24 links	(15.84 feet)

B. Description of corner evidence found and/or method applied in restoring or reestablishing corner:

No evidence of original corner or bearing trees. Restored corner position from natural feature ties north to enter swamp and lake, east to top of ridge, south and west to swamp edges. Retracement distances north, east and west to recovered corners are in accordance with the original field notes.

SURVEY &  
REMONUMENTATION


MAY 16 1997

COMMISSION

C. Description of monument for corner and accessories established to perpetuate localing the position of the corner:  
At the corner position I set a standard 2" diameter by 30" long split base aluminum monument with a 3 1/4" aluminum cap stamped to read: T.47-46N., R.37W.; S.35, S.36, S.1, S.2; 1993; R.L.S. 21564; from which I established the following new blazed and scribed bearing trees and/or reference objects:

20"	Sugar Maple	N.21°E.	11.19 feet
10"	Sugar Maple	S.30°E.	17.41 feet
10"	Sugar Maple	S.45°W.	12.69 feet

A 6' steel sign post bears: S.79°W. 0.57 feet.

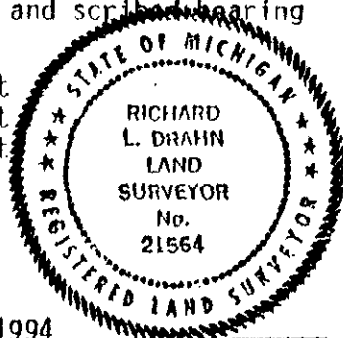

Signed by Richard L. Drahn Date February 16, 1994

Surveyor's Michigan License No. 21564  
U.S.F.S. Z-21  
A-24