APPROVED FOR
4/6/95
R.W. Douglas

229

LAND CORNER RECORDATION CERTIFICATE

Filing Requirement of Act 74, Mich. P.A. 1970

For corners in HOUGHTON & ~~IRON~~ (County)

	Located in:	Corner Code ~~-11~~
1. Public Land Survey	T 47-46N R 37W	~~L-1~~ L-13
	T ___ R ___	
	T ___ R ___	
	T ___ R ___	
2. Property Controlling	S ___ T ___ R ___	
in Section	S ___ T ___ R ___	
3. Miscellaneous	S ___ T ___ R ___	
Property in Sec.	S ___ T ___ R ___	

REGISTER'S OFFICE
Houghton County, Mich. } ss.
Received for record the 25 day of April A. D., 1995, at 8:00 o'clock A. M. and recorded in Vol. 3 of Special Corner Page 229
Register
Register of Deeds Stamp & File Number

4. Lot No. ___, Recorded Plat ___
5. Private Claims ___

¼ Corner, Sections 36, 1; T.47-46N., R.37W.

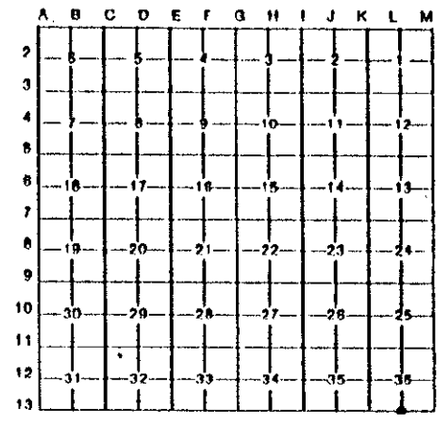

I, Richard L. Drahn, in a field survey on December 6, 19 93, do hereby certify that under requirements of P.A. 74, Michigan P.A. of 1970, the corner points mentioned in lines 1 and 2 above were in conformance with regulations and rules therefore as required in the current manual of survey instructions of the United States Department of the Interior, Bureau of Land Management or by a decree of a Court of Law and/or that the corner points mentioned in lines 3, 4 and 5 above were in conformance with the rules of the Michigan Board of Land Surveyors or by a Decree of a Court of Law; established, re-established, monumented, re-monumented, recovered, found as expressed below:

NOTE: Not more than 4 corners, all in the same town and range, may be recorded on this certificate.

A. Description of original monument and accessories and/or subsequent restoration:

Corner established by John Burt, U.S. Deputy Surveyor, on June 15, 1847.
Original bearing trees:

Hemlock	18"	N.37°W.	17 links	(11.22 feet)
Hemlock	9"	N.64°W.	24 links	(15.84 feet)

B. Description of corner evidence found and/or method applied in restoring or reestablishing corner:

No evidence of original corner or bearing trees found. Re-established corner by single proportion measure on a line between the S.E. and the S.W. corner of Section 36, T.47N., R.37W.

SURVEY & REMONUMENTATION
MAY 16 1997
COMMISSION

C. Description of monument for corner and accessories established to perpetuate locating the position of the corner:

At the corner position I set a standard 2" diameter by 30" long split base aluminum monument with a 3¼" aluminum cap stamped to read: T.47-46N., R.37W.; ¼; S.36, S.1; 1993; R.L.S. 21564: from which I established the following new blazed and scribed bearing trees and/or reference objects:

10"	Sugar Maple	N.84°E.	16.75 feet
12"	Red Maple	S.64°E.	16.31 feet
8"	Aspen	S.19°W.	12.33 feet

A 6' steel sign post bears: N.26°W. 0.55 feet

Signed by Richard L. Drahn Date February 16, 1994

Surveyor's Michigan License No. 21564

U.S.F.S. Z-23
~~A-23~~

FORM APPROVED BY MICHIGAN STATE BOARD OF LAND SURVEYORS, JAN. 28, 1971
REVISED MAY 14, 1975
REVISED JAN., 1983