APPROVED
P.A.
Houghton County
4/5/95
R.W. Campbell

231

# LAND CORNER RECORDATION CERTIFICATE

**Filing Requirement of Act 74, Mich. P.A. 1970**

For corners in HOUGHTON (County)

| | Located In: | Corner Code # |
|---|---|---|
| 1. Public Land Survey | T 47N R 37W | M-12 |
| | T 47N R 36W | A-12 |
| | T ___ R ___ | |
| | T ___ R ___ | |
| 2. Property Controlling | S ___ T ___ R ___ | |
| In Section | S ___ T ___ R ___ | |
| 3. Miscellaneous | S ___ T ___ R ___ | |
| Property in Sec. | S ___ T ___ R ___ | |

REGISTER'S OFFICE } ss.
Houghton County, Mich.
Received for record the 25th day of April A. D., 1995, at 9:00 o'clock A.M. and recorded in Vol. 3 of Land Corner Page 231
Register

Register of Deeds Stamp & File Number

4. Lot No. _____, Recorded Plat _____
5. Private Claims _____

¼ Corner, Sections 36, 31; T47N., R.37-36W.

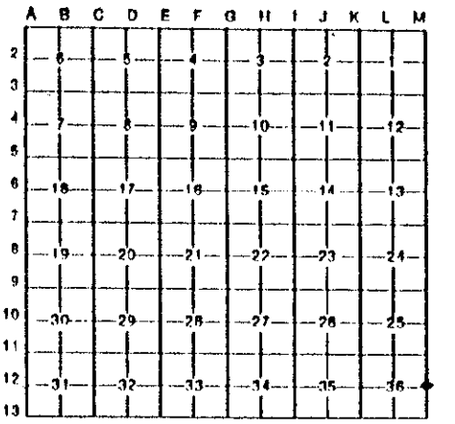


I, Richard L. Drahn, in a field survey on December 13, 19 93, do hereby certify that under requirements of P.A. 74, Michigan P.A. of 1970, the corner points mentioned in lines 1 and 2 above were in conformance with regulations and rules therefore as required in the current manual of survey instructions of the United States Department of the Interior, Bureau of Land Management or by a decree of a Court of Law and/or that the corner points mentioned in lines 3, 4 and 5 above were in conformance with the rules of the Michigan Board of Land Surveyors or by a Decree of a Court of Law; established, re-established, monumented, re-monumented, recovered, found as expressed below:

**NOTE: Not more than 4 corners, all in the same town and range, may be recorded on this certificate.**

A. Description of original monument and accessories and/or subsequent restoration:

Corner established by John Burt, U.S. Deputy Surveyor, on June 17, 1847. Original bearing trees:

| | | | | |
|---|---|---|---|---|
| Hemlock | 20" | S.20°E. | 10 links | ( 6.60 feet) |
| Hemlock | 18" | N.08°W. | 17 links | (11.22 feet) |

B. Description of corner evidence found and/or method applied in restoring or reestablishing corner:

No evidence of original corner or bearing trees found. Re-established corner position by single proportion measure on line between the N.E. and the S.E. corner of Section 36, T.47N., R.37W.

SURVEY & REMONUMENTATION
MAY 16 1997
COMMISSION

STATE OF MICHIGAN
RICHARD L. DRAHN
LAND SURVEYOR
No. 21564
REGISTERED LAND SURVEYOR

C. Description of monument for corner and accessories established to perpetuate locating the position of the corner:

At the corner position I set a standard 2" diameter by 30" long split base aluminum monument with a 3¼" aluminum cap stamped to read: T.47N., R.37-36W.; ¼; S.36, S.31; 1993; R.L.S. 21564; from which I established the following new blazed and scribed bearing trees and/or reference objects:

| | | | |
|---|---|---|---|
| 14" | Sugar Maple | N.89°W. | 13.95 feet |
| 14" | Sugar Maple | N.17°E. | 13.12 feet |
| 10" | Sugar Maple | S.21°E. | 11.18 feet |

A 6' steel sign post bears: S.35°W., 1.00 feet.

Signed by Richard L. Drahn Date February 11, 1994

Surveyor's Michigan License No. 21564

U.S.F.S. X-25

FORM APPROVED BY MICHIGAN STATE BOARD OF LAND SURVEYORS, JAN. 28, 1971
REVISED MAY 14, 1979
REVISED JAN., 1983