

LAND CORNER RECORDATION CERTIFICATE
Filing Requirement of Act 74, Mich. P.A. 1970

4/5/95
RW Camps
For corners in HOUGHTON Iron (County)

Located In:

Corner Code =/1

- 1. Public Land Survey T 47N R 37W
2. Property Controlling In Section S T 46N R 36W
3. Miscellaneous Property In Sec. S T

M-13
H-13
M-01
A-01

REGISTER'S OFFICE

Houghton County, Mich.

Received for record the... day
of... A. D., 19... at...
'clock... M. and recorded in Vol. ...
Page...
Register of Deeds Stamp & File Number

4. Lot No. ... Recorded Plat ...
5. Private Claims ...
Section Corner, Sections 36, 31, 1, 6; T.47-46N., R37-36W.

Grid table with columns A-M and rows 2-13 containing numbers 1-36.

I, Richard L. Drahn, in a field survey on December 6, 1993, do hereby certify that under requirements of P.A. 74, Michigan P.A. of 1970, the corner points mentioned in lines 1 and 2 above were in conformance with regulations and rules therefore as required in the current manual of survey instructions of the United States Department of the Interior, Bureau of Land Management or by a decree of a Court of Law and/or that the corner points mentioned in lines 3, 4 and 5 above were in conformance with the rules of the Michigan Board of Land Surveyors or by a Decree of a Court of Law; established, re-established, monumented, re-monumented, recovered, found as expressed below: Southeast Township Corner of T.47N., R.37W.

NOTE: Not more than 4 corners, all in the same town and range, may be recorded on this certificate.

A. Description of original monument and accessories and/or subsequent restoration:

Corner established by John Burt, U.S. Deputy Surveyor, on September 22, 1846. Original bearing trees:

Y. Birch 24" S.57°E. 12 links (7.92 feet)
Sugar 20" N.60°W. 46 links (30.36 feet)

B. Description of corner evidence found and/or method applied in restoring or reestablishing corner:

Restored corner position by retracement measurement from recovered corners and from natural features; north, south, east and west.

SURVEY & REMONUMENTATION

MAY 16 1997


COMMISSION

C. Description of monument for corner and accessories established to perpetuate locating the position of the corner:

At the corner position I set a standard 2" diameter by 30" long split base aluminum monument with a 3 1/2" aluminum cap stamped to read: T.47-46N., R.37-36W.; S.36, S.1, S.31, S.6; 1993; R.L.S. 21564: from which I established the following new blazed and scribed bearing trees and/or reference objects:

10" Sugar Maple N.46°W. 23.62 feet
10" Sugar Maple N.11°W. 18.80 feet
10" Sugar Maple N.31°E. 20.43 feet

A 6' steel sign post bears: South 0.73 feet.

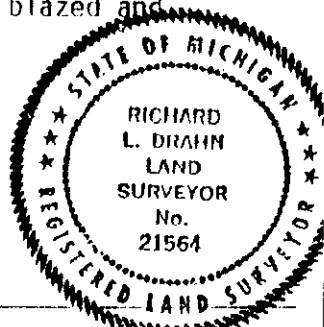

Signed by Richard L. Drahn

Date March 2, 1994

Surveyor's Michigan License No. 21564