

LAND CORNER RECORDATION CERTIFICATE
Filing Requirement of Act 74, Mich. P.A. 1970

For corners in
HOUGHTON & Ontonagon
(County)

Located In: Corner Code #
T 48N R 37-38W -M-3 A-3
T R
T R
T R
S T R
S T R
S T R
S T R

REGISTER'S OFFICE
Houghton County, Mich.
Received for record the 25th day
of April, 1994 A.D., at 8:45
o'clock, P.M. and recorded in Vol. 3
of the Equal Land Registry Page 285
Register of Deeds Stamp & File Number

4. Lot No. , Recorded Plat
5. Private Claims

Section corner, Sections 6, 7, 1, 12; T.48N., R.37-38W.

I, Richard L. Drahn, in a field survey on October 28, 1993, do hereby certify that under requirements of P.A. 74, Michigan P.A. of 1970, the corner points mentioned in lines 1 and 2 above were in conformance with regulations and rules therefore as required in the current manual of survey instructions of the United States Department of the Interior, Bureau of Land Management or by a decree of a Court of Law and/or that the corner points mentioned in lines 3, 4 and 5 above were in conformance with the rules of the Michigan Board of Land Surveyors or by a Decree of a Court of Law; established, re-established, monumented, re-monumented, recovered, found as expressed below:

NOTE: Not more than 4 corners, all in the same town and range, may be recorded on this certificate.

A. Description of original monument and accessories and/or subsequent restoration:

Corner established by Austin Burt, U.S. Deputy Surveyor, on June 18, 1847.

Original bearing trees:

Table with 4 columns: Tree Type, Diameter, Bearing, Distance. Includes entries for Sugar trees with diameters of 15, 10, 10, and 12 inches.

B. Description of corner evidence found and/or method applied in restoring or reestablishing corner:

Restored corner position from the stump holes of four original bearing trees. Distance and line to monumented corners north, south and east are in accordance with the original field notes. 1958 Forest Service location posted on 5" Ironwood N.20°W., 15.6 feet from corner position.

SURVEY &
REMONUMENTATION

MAY 16 1997


COMMISSION

C. Description of monument for corner and accessories established to perpetuate locating the position of the corner:

At the corner position I set a standard 2" diameter by 30" long split base aluminum monument with a 3/4" aluminum cap stamped to read: T.48N., R.37-38W.; S.1, S.6, S.7, S.12; 1993; R.L.S. 21564: from which I established the following new blazed and scribed bearing trees and/or reference objects:

Table with 4 columns: Diameter, Tree Type, Bearing, Distance. Includes entries for 10" Sugar Maple, 10" Sugar Maple, and 6" Ironwood.

A 6' steel sign post bears: S.62°E. 1.32 feet

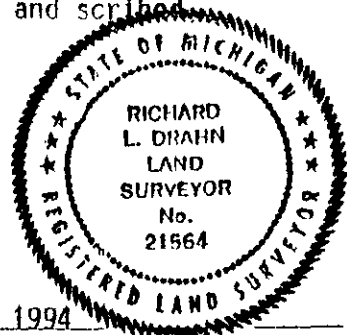

Signed by Richard L. Drahn Date February 16, 1994

Surveyor's Michigan License No. 21564

U.S.F.S. E-25
E-1