

APPROVED LAND CORNER  
For  
Houghton County

2017

LAND CORNER RECORDATION CERTIFICATE  
Filing Requirement of Act 74, Mich. P.A. 1970

For corners in  
HOUGHTON & ANTONAGON  
(County)

Located In: Corner Code #/

- 1. Public Land Survey T 48N R 30-37W -M-4 A-4
- T R
- T R
- T R
- 2. Property Controlling S T R
- in Section S T R
- 3. Miscellaneous S T R
- Property in Sec. S T R

REGISTER'S OFFICE  
Houghton County, Mich. ss.

Received for record the 25<sup>th</sup> day  
of April A. D. 1985 at 9:00  
o'clock A. M. and recorded in Vol. 3  
of the Survey Page 207  
.....  
Register

Register of Deeds Stamp & File Number

- 4. Lot No. \_\_\_\_\_ Recorded Plat \_\_\_\_\_
- 5. Private Claims \_\_\_\_\_

1 Corner, Sections 7, 12; T.48N., R.37-38W.

I, Richard L. Drahn, in a field survey on December 2, 19 93, do hereby certify that under requirements of P.A. 74, Michigan P.A. of 1970, the corner points mentioned in lines 1 and 2 above were in conformance with regulations and rules therefore as required in the current manual of survey instructions of the United States Department of the Interior, Bureau of Land Management or by a decree of a Court of Law and/or that the corner points mentioned in lines 3, 4 and 5 above were in conformance with the rules of the Michigan Board of Land Surveyors or by a Decree of a Court of Law; established, re-established, monumented, re-monumented, recovered, found as expressed below:

	A	B	C	D	E	F	G	H	I	J	K	L
2	1	2	3	4	5	6	7	8	9	10	11	12
3												
4	7	8	9	10	11	12						
5												
6	13	14	15	16	17	18	19	20	21	22	23	24
7												
8	19	20	21	22	23	24						
9												
10	25	26	27	28	29	30	31	32	33	34	35	36
11												
12	31	32	33	34	35	36						
13												

NOTE: Not more than 4 corners, all in the same town and range, may be recorded on this certificate.

A. Description of original monument and accessories and/or subsequent restoration:

Corner established by Austin Burt, U.S. Deputy Surveyor, on June 18, 1847.  
Original bearing trees:

Spruce	26"	S. 32° E.	14 links	( 9.24 feet)
Hemlock	18"	N. 42° W.	24 links	(15.84 feet)

B. Description of corner evidence found and/or method applied in restoring or reestablishing corner:

Restored corner position at record bearing and distance from stump remains of both original bearing trees. The 6.15 chain distance south to the "left bank of stream" and the 0.50 chain distance north to "ascend hill" are in accordance with the original field notes. Found a 14" cedar with Forest Service location poster and blazes with 92 years of growth over them at S.20°E., 12.9 feet.

SURVEY &  
REMONUMENTATION

MAY 16 1997


COMMISSION

C. Description of monument for corner and accessories established to perpetuate locating the position of the corner:

At the corner position I set a standard 2" diameter by 30" long split base aluminum monument with a 3 1/4" aluminum cap stamped to read: T.48N., R.37-38W.; 1/4; S.7, S.12; 1993; R.L.S. 21564: from which I established the following new blazed and scribed bearing trees and/or reference objects:

8"	Yellow Birch	N.88°E.	2.78 feet
8"	Spruce	S.04°E.	3.89 feet
12"	Black Ash	S.60°W.	16.88 feet

A 6' steel sign post bears: S.81°W. 1.21 feet

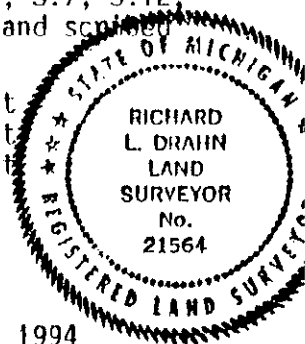

Signed by Richard L. Drahn Date February 16, 1994

Surveyor's Michigan License No. 21564

U.S.F.S. -G-25-  
G-1