

LAND CORNER RECORDATION CERTIFICATE  
Filing Requirement of Act 74, Mich. P.A. 1970

4/5/95  
RW Adams  
For corners in  
HOUGHTON  
(County)

	Located In:	Corner Code #
1. Public Land Survey	T 48N R 37W	B-3
	T _____ R _____	_____
	T _____ R _____	_____
	T _____ R _____	_____
2. Property Controlling in Section	S _____ T _____ R _____	_____
	S _____ T _____ R _____	_____
3. Miscellaneous Property in Sec.	S _____ T _____ R _____	_____
	S _____ T _____ R _____	_____

REGISTER'S OFFICE } ss.  
Houghton County, Mich.  
Received for record the 25<sup>th</sup> day  
of April, A. D., 1995 at 5:00  
o'clock P.M. and recorded in Vol. 27  
of Land Corner Page 288  
Richard L. Drahn Register

Register of Deeds Stamp & File Number

4. Lot No. \_\_\_\_\_, Recorded Plat \_\_\_\_\_  
5. Private Claims \_\_\_\_\_

1/4 Corner, Sections 6, 7; T.48N., R.37W.

I, Richard L. Drahn, in a field survey on October 28, 1993, do hereby certify that under requirements of P.A. 74, Michigan P.A. of 1970, the corner points mentioned in lines 1 and 2 above were in conformance with regulations and rules therefore as required in the current manual of survey instructions of the United States Department of the Interior, Bureau of Land Management or by a decree of a Court of Law and/or that the corner points mentioned in lines 3, 4 and 5 above were in conformance with the rules of the Michigan Board of Land Surveyors or by a Decree of a Court of Law established, re-established, monumented, re-monumented, recovered, found as expressed below:

	A	B	C	D	E	F	G	H	I	J	K	L	M
2													
3													
4													
5													
13													

NOTE: Not more than 4 corners, all in the same town and range, may be recorded on this certificate.

A. Description of original monument and accessories and/or subsequent restoration:

Corner established by Artimus Cortis, U.S. Deputy Surveyor, on August 13, 1851.  
Original bearing trees:

Sugar	8"	N.68°W.	8 links	(5.28 feet)
Lynn	15"	S.70°E.	14 links	(9.24 feet)

B. Description of corner evidence found and/or method applied in restoring or reestablishing corner:

All original evidence destroyed by road construction. Corner was re-established by single proportion measure midway on a line between the N.E. corner and the N.W. corner of Section 7.

SURVEY &  
REMONUMENTATION

MAY 16 1997


COMMISSION

C. Description of monument for corner and accessories established to perpetuate locating the position of the corner:

At the corner position I set a standard 2" diameter by 30" long split base aluminum monument with a 3 1/2" aluminum cap stamped to read: T.48N., R.37W.; 1/4; S.6, S.7; 1993; R.L.S. 21564: from which I established the following new blazed and scribed bearing trees and/or reference objects:

8"	Ironwood	N.04°W.	10.13 feet
18"	Hemlock	N.59°E.	29.93 feet
8"	Sugar Maple	S.60°E.	2.28 feet

A 6' steel sign post bears: N.03°W. 1.25 feet

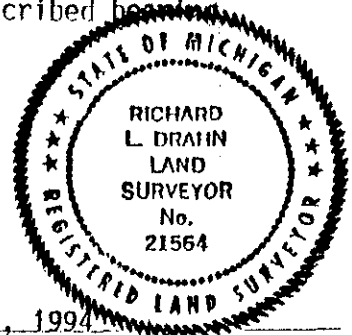

Signed by Richard L. Drahn Date February 16, 1994

Surveyor's Michigan License No. 21564