

LAND CORNER RECORDATION CERTIFICATE
Filing Requirement of Act 74, Mich. P.A. 1970

APPROVED BY THE BOARD

4/5/96
R.W. Coyle

For corners in
HOUGHTON
(County)

Located In:	Corner Code #1
1. Public Land Survey	T <u>48N.</u> R <u>37W</u> D-3
	T _____ R _____
	T _____ R _____
	T _____ R _____
2. Properly Controlling in Section	S _____ T _____ R _____
	S _____ T _____ R _____
3. Miscellaneous Properly in Sec.	S _____ T _____ R _____
	S _____ T _____ R _____

REGISTER'S OFFICE
Houghton County, Mich.
Received for record the 25th day
of April A. D., 1995, at 9:50
o'clock, A.M. and recorded in Vol. 3
of Land Corner Page 211
R.W. Coyle Register
Register of Deeds Stamp & File Number

4. Lot No. _____, Recorded Plat _____
5. Private Claims _____

$\frac{1}{4}$ Corner, Sections 5, 8; T.48N., R.37W.

I, Richard L. Drahn, in a field survey on September 28, 1993, do hereby certify that under requirements of P.A. 74, Michigan P.A. of 1970, the corner points mentioned in lines 1 and 2 above were in conformance with regulations and rules therefore as required in the current manual of survey instructions of the United States Department of the Interior, Bureau of Land Management or by a decree of a Court of Law and/or that the corner points mentioned in lines 3, 4 and 5 above were in conformance with the rules of the Michigan Board of Land Surveyors or by a Decree of a Court of Law, established, re-established, monumented, re-monumented, recovered, found as expressed below:


NOTE: Not more than 4 corners, all in the same town and range, may be recorded on this certificate.

A. Description of original monument and accessories and/or subsequent restoration:

Corner established by Artimus Curtis, U.S. Deputy Surveyor, on August 13, 1851.
Original bearing trees:

Cedar	12"	N.31°E.	12 links	(7.92 feet)
Spruce	14"	S.29°W.	23 links	(15.18 feet)


B. Description of corner evidence found and/or method applied in restoring or reestablishing corner:

All original evidence destroyed by road construction. Corner was re-established by single proportion measure on line between the S.E. corner and the S.W. corner of Section 5.

SURVEY &
REMONUMENTATION

MAY 16 1997

COMMISSION

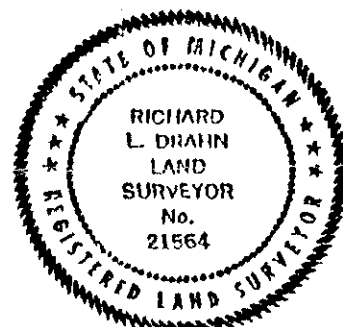

C. Description of monument for corner and accessories established to perpetuate locating the position of the corner:

At the corner position and 6" below surface of an E-W road I set a 2" dia. by 12" long concrete filled, galvanized iron pipe with a 3" brass cap stamped: T.48N., R.37W; $\frac{1}{4}$; S.5, S.8; 1993; R.L.S. 21564: from which I established the following bearing trees and reference objects:

16"	White Pine	N.55°W.	51.10 feet
8"	White Spruce	N.29°W.	30.80 feet
6"	White Spruce	S.73°W.	35.94 feet
6'	Steel sign post	S.20°W.	22.52 feet

A standard 30" long, aluminum reference monument with a 3 1/4" alum cap, stamped to indicate corner position bears: S.19°E., 21.65 feet.

Signed by Richard L. Drahn Date February 16, 1994

Surveyor's Michigan License No. 21564
U.S.F.S. E-7