


LAND CORNER RECORDATION CERTIFICATE
Filing Requirement of Act 74, Mich. P.A. 1970

For corners in

<u>Houghton</u> (County)	Located In:	Corner Code #
1. Public Land Survey	T <u>51N</u> R <u>35W</u>	<u>69</u>
	T _____ R _____	_____
	T _____ R _____	_____
	T _____ R _____	_____
2. Property Controlling in Section	S _____ T _____ R _____	_____
	S _____ T _____ R _____	_____
3. Miscellaneous Property in Sec.	S _____ T _____ R _____	_____
	S _____ T _____ R _____	_____

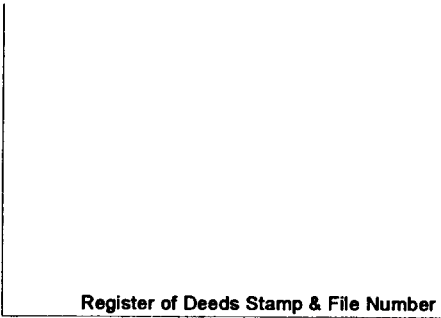

4. Lot No. _____, Recorded Plat _____
 5. Private Claims _____

Apr 13 1999

I, Stephan J. Szyszkoski, in a field survey on _____, 19____ do hereby state that under requirements of P.A. 74, Michigan P.A. of 1970, the corner points mentioned in lines 1 and 2 above were in conformance with regulations and rules therefore as required in the current manual of survey instructions of the United States Department of the Interior, Bureau of Land Management or by a decree of a Court of Law and/or that the corner points mentioned in lines 3, 4 and 5 above were in conformance with the rules of the Michigan Board of Land Surveyors or by a Decree of a Court of Law; established, re-established, monumented, recovered, found as expressed below:

NOTE: Not more than 2 corners, all in the same town and range, may be recorded on this certificate.

A	B	C	D	E	F	G	H	I	J	K	L	M
1												
2	6		5		4		3		2		1	
3												
4	7		8		9		10		11		12	
5												
6	18		17		16		15		14		13	
7												
8	19		20		21		22		23		24	
9												
10	30		29		28		27		26		25	
11												
12	31		32		33		34		35		36	
13												

A. Description of original monument and accessories and/or subsequent restoration:
 (69) Corner common to Sections 21-22-27-28. Corner established in 1848 by Sylvester Higgins: North between Sections 27 & 28...80.00 Set post corner Secs. 21,22,27,28. Sugar 10 N80E 16, do 10 S41W 19." Found no subsequent record.

B. Description of corner evidence found and/or method applied in restoring or reestablishing corner:
 (69) Original post and accessories presumably destroyed by road construction and were not recovered. I reestablished the corner in the intersection of North Laird and Tauriainen roads according to old Right-of-Way fences which I recovered along the S.side of N.Laird Rd. and the E. side of Tauriainen Rd. My measurements are as follows: 1) Found recorded 1/4 corner 2629.19' east (2626.8R); 2) reestablished 1/4 corner 2635.65' north (2640R); 3) old Right-of-Way fences 33.0' south; 4) old fence line along Tauriainen road, 25.0' east (fencelines on each side of this road were found separated by 50.0'); 5) old 1/16 line fence, 1313.6' west; 6) old quarter line fence and reestablished 1/4 corner 2625.77' west (2649.9'R). Placed a 1"ID x 32" iron pipe capped with a 4" dia. cast aluminum MDNR tablet, appropriately stamped, at the corner position and drove it to 6" below the gravel road surface. The intersection of the physical centerlines of the county roads at this corner is about 3' east.

C. Description of monument for corner and accessories established to perpetuate locating the position of the corner:
 (69) Set 1" pipe with 4" MDNR cap.
 Power pole N48E 37.2' PK nail/washer
 Power pole S19E 74.3' PK nail/washer
 Telephone riser S62W 65.1' to center
 Power pole N68W 74.0' PK nail/washer
 Bearings are magnetic.



Signed by Stephan J. Szyszkoski
 Surveyor's Michigan License No. 33986

Date 8/26/99

For the Michigan Department of Natural Resources - Forest Management Division