

LAND CORNER RECORDATION CERTIFICATE
Filing Requirement of Act 74, Mich. P.A. 1970 as Amended

For corners in

<u>Houghton</u> (County)	Located In:	Corner Code #
1. Public Land Survey	T <u>51N</u> R <u>35W</u>	<u>J9</u>
	T _____ R _____	_____
	T _____ R _____	_____
	S _____ T _____ R _____	_____
2. Property Controlling in Section	S <u>22</u> T <u>51N</u> R <u>35W</u>	<u>7</u>
	S _____ T _____ R _____	_____
3. Miscellaneous Property in Sec.	S _____ T _____ R _____	_____
	S _____ T _____ R _____	_____

Register of Deeds Stamp & File Number

4. Lot No. _____, Recorded Plat _____
 5. Private Claims

7 May 24 2006
 J9 Apr 20 2006

I, Stephan J. Szyszkoski, in a field survey on _____, 20____ do hereby state that under requirements of P.A. 74, Michigan P.A. of 1970, the corner points mentioned in lines 1 and 2 above were in conformance with regulations and rules therefore as required in the current manual of survey instructions of the United States Department of the Interior, Bureau of Land Management or by a decree of a Court of Law and /or that the corner points mentioned in lines 3, 4 and 5 above were in conformance with the rules of the Michigan Board of Land Surveyors or by a Decree of a Court of Law; established, re-established, monumented, recovered, found as expressed below:

NOTE: Not more than 2 corners, all in the same town and range, may be recorded on this certificate.

A. Description of original monument and accessories and/or subsequent restoration:

(J9) Quarter corner common to Sections 23 and 26. 1973 - A.O. Enger RLS recovered and accepted a 1-3/4" ID iron pipe found buried in approx. construction centerline of county road, in line with old N-S fence on South side of road. Witnesses: Power Pole N60W 47.40', Fence Corner Post S10W 31.90'


(7-Sec. 22) North 1/16 corner between Sections 22 and 23. Not established in the original survey. 1966 - Recorded by Billy D. Buckler RLS as follows: Placed 1/16 corner midway on half mile and on West edge, old grade clearing, Found Wood Post 25.0' to South. Set Wood Post. Witnesses: 9" Soft Maple N47W 40.7', 13" Soft Maple N46E 60.0'.

B. Description of corner evidence found and/or method applied in restoring or reestablishing corner:

(J9) Recovered the 1-3/4" ID iron pipe described in Mr. Enger's LCRC, dated 1974. The top of the pipe is approx 8" below the road surface and is bent. Drove a spike over the monument at the location of the lower portion of the pipe, found set plumb. The Power Pole witness from 1973 checks. The fence post S10W was not identified, its location being among a number of downed, rotting posts. (7-Sec. 22) The 1966 position for the corner was not recovered. Reestablished the corner midway and on line between Section corner 1320.85' north and Quarter corner 1320.85' south.

C. Description of monument for corner and accessories established to perpetuate locating the position of the corner:

(J9) Fd. 1-3/4" ID iron pipe. Drove 3/8" x 8" spike over, set 0.2' below road surface. Set measuring nails in: 10" R.Pine S11E 35.3' wrkd "1/4S NBT" 4" Apple N31W 26.2' do Power Pole 23L40 N56W 47.4' exist. nail Power Pole 23R25 N86E 144.7' Bearings are magnetic. Distance are to nail with tag. Corner is about 6' north of construction C/L of asphalt rd.,	(7) Set 1"IDx32" I.pipe with 4" alum. MDNR cap. Set measuring nails in: 6" Y.Birch S10W 66.4' wrkd "1/16S BT" 4" Balsam S41W 4.2' do 20" Hemlock N74W 68.0' do 6" Maple in clump N01W 5.1' do Set sq'd cedar post adjacent. Bearings are magnetic. Distances are to nail with tag. C/L Hazel Swamp Rd. is about 19' East.
---	---

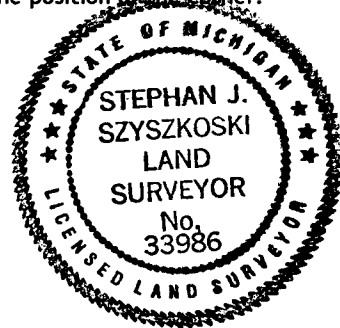

Signed by Stephan J. Szyszkoski
 Surveyor's Michigan License No. 33986

Date 10/2/06

For the Michigan Department of Natural Resources, Office of Land and Facilities

