

MICHIGAN
DEPARTMENT OF CONSERVATION
FORESTRY DIVISION

LAND CORNER RECORD

T. 51 N.R. 35 W


Houghton COUNTY

DESCRIPTION OF CORNER Section Corner common to Secs. 20-21-28-29

CORNER MONUMENT 1 1/4" X 30" Iron Pipe (driven in Center of road)

DATE MONUMENT PLACED AND WITNESSED 6/6/1966

WITNESSES TO CORNER..... No Witnesses

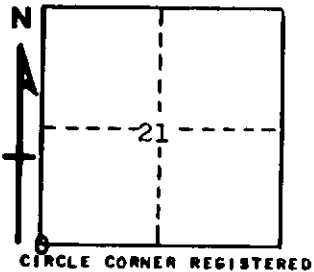

AND

DESCRIPTION IN DETAIL AS TO HOW CORNER WAS LOCATED AND IDENTIFIED OR RESTORED.

This Corner placed Midway between two old fence lines, 25' North of Fence Line and in Line with Fence to North.

Corner lies 27.5' West of a fence line running approximately South.

Pipe driven 6" below the present road surface.

SURVEYOR'S SEAL

Billy D. Buckler

SIGNED Billy D. Buckler DATE 8/12/1966
REGISTERED LAND SURVEYOR