
## LAND CORNER RECORDATION CERTIFICATE

## FILING REQUIREMENT OF ACT 74, MICH. P.A.1970

	FOR CORNERS OF	<del>-</del> :	LOCATED IN -:	CORNER COD	E NUMBER	
	1. PUBLIC LAND	SURVEY	T. 51 xx, R. 35		L7	
	2. PROPERTY CO	ONTROLL- 11 SECTION 11	,T. 51 XX, R. 35	ж <sup>ж</sup> 16		
	3. MISCELLANEO PROPERTY IN	us section———	,T N N	E. W.		
	4. LOT NO, RECORDED PLAT					
	5. PRIVATE CLAI	MS	<del></del>			REGISTER OF DEEDS STAMP AND FILING NUMBER
	Arthur O. Enger  do hereby certify that under requirements of P.A. 74, Michigan P.A. of 1970, the corner points mentioned in lines 1 and 2 above (identified with circles on index code diagram—over) were, in a field survey on see below 19, established, re-established, monumented, re-monumented, recovered or restored as expressed below and in conformance with regulations and rules therefore as required in the current manual of survey instructions of the United States Department of the Interior, Bureau of Land Management or by a decree of a court of law. Furthermore, that the corner points mentioned in lines 3, 4 and 5 above were, in a field survey on 19, found, recovered, restored, established or re-established as expressed below and in con-					
	formance with the rules of the Michigan State Board of Registration for Land Surveyors or, by a Decree of a Court of law:					
	A. Description of original monument and accessories and/or subsequent restoration:  Corner J5: Wood post (Not found. No subsequent monuments found.)  Cedar 10 N56W 21 (Probably found)  Cedar 12 S54E 6 (Probably found)					
	original	L7: As the evidence has	nese corners fal as long since be		constructi	
species, 39.536 c scar rem Corner J centerli with oth Corner L of const property	absolute and h. W (original nants on stump 9: Witnessed ne of a county er corners and 7: Replaced or ruction center line fences i 6. Establishe Corner J5: Corner J9:	relative sincorner) at corner) at to NW. on 11/7/73 road, in lifence line in 11/7/73 at lines of in the local of 10/25/73 of monument for 1" I.D. x Cedar 12 Hemlock 10 1-3/4" I.I Power Pole Fence Corner 1/2" I.D. Power Pole Fence Corner 1/2" I.	lze, distance, & nd 39.806 ch. E  a 1-3/4 inch I.line with an old line with an old line salong this road lives expecting countity.  on line between recorner and accessor 36" Iron pipe with S41°E (mag.)  0. iron pipe, let lives (mag.)  1. iron pipe, let lives (mag.)  2. N60°W (mag.)  3. iron pipe, let lives (mag.)  4. N46°E (mag.)  4. West (mag.)  4. N46°E (mag.)	bearing, and in (not known to be ). iron pipe four N&S fence on S ad. be found buried by roads. Appear 1/4 corner 19.9 les established to per 1/4 s. 13.2 ft. "1/4S, 13.2 ft. "1/4S, 13.40 ft. mag.) 31.90 ft.	alinement original) nd buried side of ro in the roa rs consist 03 ch. W & rectuate local cap. NBT" Distances ces to hea 11, 14" 5, BT"	the original BT's in with section corners. Possible overgrowth in approx. construction ad. Appears consistent d bed at the intersection ent with long standing. Sec. Cor. 19.903 ch. E. ting the position of the corner:  to head of a nail.  d of a nail.
	SIGNED BY		_		•	
	SURVEYOR'S MICHIGAN REGISTRATION NO (SEAL)  FOR STATE AND UNITED STATES AGENCIES:					
	SIGNED BY	<del></del>	CHIEF OF SURVEY PARTY	D.	ATE	The state of the s
	APPROVED AND	SIGNED BY_	MICHIGAN REGISTE Arthur 0.	D.  JEG LAND STVEYOR Enger	_ DATEA	pril 17, 1974
		Mich	ngan bepartment	or Natural Resor	arces	
	SURVEYOR'S MIC		STRATION NO	FORM APPROVED BY MICH	 IGAN STATE BOA AN SOCIETY OF I	RD OF REGISTHATION SAN. 25. 1371


## CORNER NUMBERING CODE DIAGRAMS FOR IDENTIFYING LAND CORNER RECORDATIONS AND INDEXING

FOR PUBLIC LAND SURVEY CORNERS IN THE T. 51N , R. 35W (MENTIONED OVER)

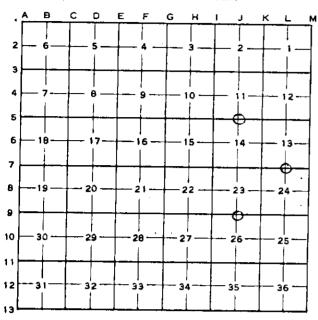

Apply letter prefix for corner points encircled above for identifying corner recordation numbers over.

FOR PROPERTY CONTROLLING AND MISC. PROPERTY CORNERS WITHIN THE SECTION (MENTIONED OVER AND EXCLUDE LOT CORNER)

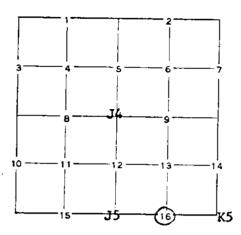

- 1. Above coded numbers are positioned on 1/16 fractional lines of the section.
- 2. Township corner code numbers shall be applied to corners of above typical section not numbered.
- 3. Miscellaneous property corners within a section, located at points other than numbered above, shall be referenced to at least two of above corner code numbers.
- 4. Private claim corners to be tied to rectangular land corners if possible sketch required below.

EXPLANATORY SKETCH IF NECESSARY -- BELOW