

MICHIGAN
DEPARTMENT OF CONSERVATION
FORESTRY DIVISION

LAND CORNER RECORD

T. 51 N.R. 35 W


Houghton COUNTY

DESCRIPTION OF CORNER Section Corner common to Secs. 22-23-26-27

CORNER MONUMENT 1/2" x 36" Iron, buried in Center of E-W Road

DATE MONUMENT PLACED AND WITNESSED 4/21/1966

WITNESSES TO CORNER..... Fence Corner 32.0' North and 18.0' East

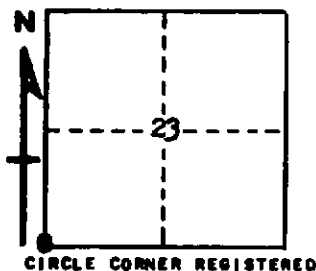

Fence Corner 32.0' South and 12.0' East

Culvert 13.0' East

AND

DESCRIPTION IN DETAIL AS TO HOW CORNER WAS LOCATED AND IDENTIFIED OR RESTORED.

Placed Iron in Intersection of E-W road and old Grade to North.

SURVEYOR'S SEAL

Billy D. Buckler

SIGNED Billy D. Buckler DATE 6/3/1966
REGISTERED LAND SURVEYOR