

**LAND CORNER RECORDATION CERTIFICATE**  
**Filing Requirement of Act 74, Mich. P.A. 1970 as Amended**

For corners in

<u>Houghton</u> (County)	Located In:	Corner Code #
1. Public Land Survey	T <u>51N</u> R <u>36W</u>	<u>K11</u>
	T <u>51N</u> R <u>36W</u>	<u>M9</u>
	T _____ R _____	_____
2. Property Controlling in Section	S _____ T _____ R _____	_____
	S _____ T _____ R _____	_____
3. Miscellaneous Property in Sec.	S _____ T _____ R _____	_____

Register of Deeds Stamp & File Number

4. Lot No. \_\_\_\_\_, Recorded Plat \_\_\_\_\_  
 5. Private Claims \_\_\_\_\_

Sep 18 2003

I, Stephan J. Szyszkoski, in a field survey on \_\_\_\_\_, 20\_\_\_\_ do hereby state that under requirements of P.A. 74, Michigan P.A. of 1970, the corner points mentioned in lines 1 and 2 above were in conformance with regulations and rules therefore as required in the current manual of survey instructions of the United States Department of the Interior, Bureau of Land Management or by a decree of a Court of Law and /or that the corner points mentioned in lines 3, 4 and 5 above were in conformance with the rules of the Michigan Board of Land Surveyors or by a Decree of a Court of Law; established, re-established, monumented, recovered, found as expressed below:

**NOTE: Not more than 2 corners, all in the same town and range, may be recorded on this certificate.**

A	B	C	D	E	F	G	H	I	J	K	L	M
1												
2	6	5	4	3	2	1						
3												
4	7	8	9	10	11	12						
5												
6	18	17	16	15	14	13						
7												
8	19	20	21	22	23	24						
9												
10	30	29	28	27	26	25						
11												
12	31	32	33	34	35	36						
13												

**A. Description of original monument and accessories and/or subsequent restoration:**


(K11) Corner common to Sections 25-26-35-36. 1962: Billy D. Buckler reestablished the corner from pine stumps (probable line trees) 5.70 ch. north and 6.60 ch. south, stream 3.5 ch. east, and an original corner 1/2 mile west. Set 1" pipe with 4" aluminum cap. 9" Hard Maple S28E 31 links, 9" Hard Maple S52W 43 links, 6" Y.Birch N65E 28 links.  
 (M9) Corner common to Sections 24-25 T51N-R36W and 19-30 T51N-R35W. 1962: The corner was re-monumented by Billy D. Buckler from local evidence. Set 1" ID iron pipe with 4" aluminum cap. 7" Cedar N85E 38 links, 8" Y.Birch S10E 25 links, 6" Maple S45W 12 links.

**B. Description of corner evidence found and/or method applied in restoring or reestablishing corner:**

(K11) Recovered the 1962 monument in good condition and at record bearing and distance from the 1962 NBTs. The Y.Birch and H.Maple SW are in good condition with overgrown blazes. The H.Maple SE is a dead stub with overgrown blazes. Left the monument in place and made new witnesses.  
 (M9) Recovered the 1962 monument in good condition and at record bearing and distance from the 1962 Cedar and Y.Birch NBTs, both in good condition with blazes overgrown. The 1962 Maple was not recovered. Made new witnesses as described below.

**C. Description of monument for corner and accessories established to perpetuate locating the position of the corner:**

(K11) Found 1" ID I.pipe with 4" alum. MI Dept. of Conservation cap. Blazed, scribed, and set measuring nails in: 13" twin Sugar N41W 26.8' "S26 NBT" 13" Y.Birch S19E 5.1' "S36 NBT" The 1962 NBTs: 8" Y.Birch N69E 18.6' overgrown blazes 13" Sugar S51W 28.2' do Set a sq'd cedar post adjacent. Bearings are magnetic. Distances are to nail with tag.	(M9) Found 1" ID iron pipe with 4" alum. MI Dept. of Conservation cap. Blazed, scribed, and set measuring nails in: 4" Y.Birch S40E 11.4' "S30 NBT" * 7" Cedar S47W 9.3' "S25 NBT" The 1962 NBTs: 11" Cedar N85E 24.9' overgrown blazes 11" Y.Birch S13E 15.5' do * Bearings are magnetic. Distances to nail with tag. * denotes found tag #24591
---	---

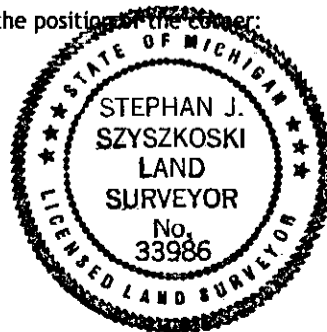

Signed by Stephan J. Szyszkoski  
 Surveyor's Michigan License No. 33986

Date 11/3/03

For the Michigan Department of Natural Resources, Office of Land and Facilities