

**LAND CORNER RECORDATION CERTIFICATE**  
**Filing Requirement of Act 74, Mich. P.A. 1970 as Amended**

For corners in

Houghton

(County)

Located In:

Corner Code #

1. Public Land Survey	T	51R	36W	K8
	T	51R	36W	I8
	T		R	
2. Property Controlling in Section	S	T	R	
	S	T	R	
3. Miscellaneous Property in Sec.	S	T	R	
	S	T	R	

Register of Deeds Stamp & File Number

4. Lot No. \_\_\_\_\_, Recorded Plat \_\_\_\_\_  
 5. Private Claims

I8 Oct 07 2003  
 K8 Sep 18 2003

	A	B	C	D	E	F	G	H	I	J	K	L	M
1													
2	6		5		4		3		2		1		
3													
4	7		8		9		10		11		12		
5													
6	18		17		16		15		14		13		
7													
8	19		20		21		22	●	23	●	24		
9													
10	30		29		28		27		26		25		
11													
12	31		32		33		34		35		36		
13													

I, Stephan J. Szyszkoski, in a field survey on \_\_\_\_\_, 20\_\_\_\_ do hereby state that under requirements of P.A. 74, Michigan P.A. of 1970, the corner points mentioned in lines 1 and 2 above were in conformance with regulations and rules therefore as required in the current manual of survey instructions of the United States Department of the Interior, Bureau of Land Management or by a decree of a Court of Law and /or that the corner points mentioned in lines 3, 4 and 5 above were in conformance with the rules of the Michigan Board of Land Surveyors or by a Decree of a Court of Law; established, re-established, monumented, recovered, found as expressed below:

**NOTE: Not more than 2 corners, all in the same town and range, may be recorded on this certificate.**

A. Description of original monument and accessories and/or subsequent restoration:


(K8) Quarter corner common to Sections 23-24. 1848: Established by S.W. Higgins: North between Sections 23 & 24...40.00 Set 1/4 Section post. Sugar 14 S72W 17, Sugar 14 N85E 34...80.00 Set post corner Sections 13, 14, 23, 24.  
 (I8) Quarter corner common to Sections 22-23. 1959: Reestablished from line tree evidence by Billy D. Buckler. Set 1" pipe with 4" brass cap. 13" Hard Maple N83W 12.5 links, 12" Hard Maple N64E 45 links, 10" Soft Maple S24E 32 links.

B. Description of corner evidence found and/or method applied in restoring or reestablishing corner:

(K8) The original post and accessories were not recovered. Reestablished the corner midway and on a straight line between Section corners 2636.06' north and south.  
 (I8) The monument of record was not recovered. Found a 9" deep x 4" dia. post hole with remains of rotted post at the corner position, at record bearing and distance from the 1959 witness trees, all recovered in good condition with overgrown blazes. There is no physical evidence that the monument called for in the record was actually installed by Mr. Buckler. Accepted the corner position and installed a monument as described below.

C. Description of monument for corner and accessories established to perpetuate locating the position of the corner:

(K8) Set 1" IDx32" I.pipe with 4" alum. MDNR cap. Blazed, scribed, and set measuring nails in: 5" Y. Birch S74E 25.7' 5" Sugar S13W 11.6' 8" Sugar N83W 12.3' 8" Sugar N26W 22.5'	"1/4S NBT" do do do	(I8) Set 1" IDx32" I.pipe with 4" alum. MDNR cap. Blazed, scribed, and set measuring nails in: 15" Sugar S58W 33.0' The 1959 wits: 18" Sugar N66E 30.3' overgrown blazes 15" Sugar S27E 22.1' 15" Sugar N83W 8.3' Squared a 3" Sugar N48E 2.6' to center. Bearings are magnetic. Distances are to nail with tag.	"1/4S NBT" do do do
---	------------------------------	---	------------------------------

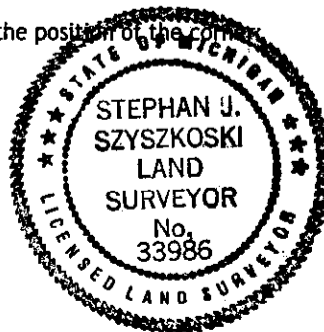

Signed by Stephan J. Szyszkoski  
 Surveyor's Michigan License No. 33986

Date 11/3/03