

LAND CORNER RECORDATION CERTIFICATE
Filing Requirement of Act 74, Mich. P.A. 1970 as Amended

For corners in

<u>Houghton</u> (County)	Located In:	Corner Code #
1. Public Land Survey	T51N R 36W	I7
	T51N R 36W	M8
	T	R
2. Property Controlling in Section	S T R	
	S T R	
3. Miscellaneous Property in Sec.	S T R	
	S T R	

Register of Deeds Stamp & File Number

4. Lot No. _____, Recorded Plat _____
 5. Private Claims

M8 Oct 08 2003
 I7 Oct 07 2003

I, Stephan J. Szyszkoski, in a field survey on _____, 20____ do hereby state that under requirements of P.A. 74, Michigan P.A. of 1970, the corner points mentioned in lines 1 and 2 above were in conformance with regulations and rules therefore as required in the current manual of survey instructions of the United States Department of the Interior, Bureau of Land Management or by a decree of a Court of Law and /or that the corner points mentioned in lines 3, 4 and 5 above were in conformance with the rules of the Michigan Board of Land Surveyors or by a Decree of a Court of Law; established, re-established, monumented, recovered, found as expressed below:

NOTE: Not more than 2 corners, all in the same town and range, may be recorded on this certificate.

A. Description of original monument and accessories and/or subsequent restoration:

A	B	C	D	E	F	G	H	I	J	K	L	M
1												
2	6	5	4	3	2	1						
3												
4	7	8	9	10	11	12						
5												
6	18	17	16	15	14	13						
7												
8	19	20	21	22	23	24						
9												
10	30	29	28	27	26	25						
11												
12	31	32	33	34	35	36						
13												


(I7) Corner common to Sections 14-15-22-23. 1959: Billy D. Buckler reestablished the corner from local evidence. Set 1"ID iron pipe with 4" brass cap. 8" Hard Maple N38W 16 links, 7" Y.Birch S20W 42 links, 6" Y.Birch S37E 31 links.
 (M8) Quarter corner common to Section 24 T51N-R36W and 19 T51N-R35W. 1845: Established by Austin Burt. North on East side of Section 24...40.00 Set qr. Section post. Fir 7 S39W 41, Birch 10 N20W 33...80.00 Set post corner of Sections 13 & 24.

B. Description of corner evidence found and/or method applied in restoring or reestablishing corner:

(I7) Recovered the 1959 monument in good condition and at record bearing and distance from the 1959 NBTs. The Y.Birch SW and the Sugar are in good condition with overgrown blazes. The Y.Birch SE is now a rotting stump. Left the monument in place and made new accessories.
 (M8) The original post and accessories were not recovered. Reestablished the corner midway and on a straight line between Section corners 2636.67' north and south.

C. Description of monument for corner and accessories established to perpetuate locating the position of the corner:

(I7) Found 1"ID I.pipe with 4" brass MI Dept. of Conservation cap. Blazed, scribed, and set measuring nails in: 8" Y.Birch N31E 30.0' "S14 NBT" 8" Sugar S36E 12.4' "S23 NBT" The 1959 wits: 10" Y.Birch S26W 28.0' overgrown blazes 9" Sugar N38W 10.8' do Bearings are magnetic. Distances are to nail with tag.	(M8) Set 1"IDx32" I.pipe with 4" alum. MDNR cap. Blazed, scribed, and set measuring nails in: 9" Maple N07W 16.0' "1/4S NBT" 9" W.Spruce N65E 16.3' do 12" dbl Maple S12E 8.7' do 9" Maple S44W 25.8' do Set sq'd spruce post adjacent. Bearings are magnetic. Distances are to nail with tag.
---	---

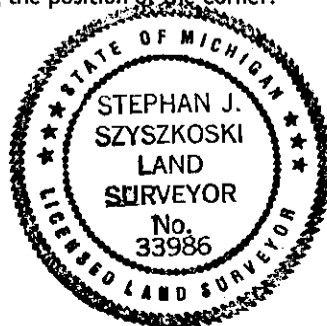

Signed by Stephan J. Szyszkoski
 Surveyor's Michigan License No. 33986

Date 11/3/03