

**LAND CORNER RECORDATION CERTIFICATE**  
**Filing Requirement of Act 74, Mich. P.A. 1970 as Amended**

For corners in

<u>Houghton</u> (County)	Located In:	Corner Code #
1. Public Land Survey	T ___ R ___	_____
	T ___ R ___	_____
	T ___ R ___	_____
2. Property Controlling in Section	S ___ T ___ R ___	_____
	S 24 T 51N R 36W	10
	S 24 T 51N R 36W	12
3. Miscellaneous Property in Sec.	S ___ T ___ R ___	_____
	S ___ T ___ R ___	_____
4. Lot No. _____, Recorded Plat _____		
5. Private Claims		

Register of Deeds Stamp & File Number

	A	B	C	D	E	F	G	H	I	J	K	L	M
1													
2	6	5	4	3	2	1							
3													
4	7	8	9	10	11	12							
5													
6	18	17	16	15	14	13							
7													
8	19	20	21	22	23	24							
9													
10	30	29	28	27	26	25							
11													
12	31	32	33	34	35	36							
13													

Oct 09 2003

I, Stephan J. Szyszkoski, in a field survey on \_\_\_\_\_, 20\_\_ do hereby state that under requirements of P.A. 74, Michigan P.A. of 1970, the corner points mentioned in lines 1 and 2 above were in conformance with regulations and rules therefore as required in the current manual of survey instructions of the United States Department of the Interior, Bureau of Land Management or by a decree of a Court of Law and /or that the corner points mentioned in lines 3, 4 and 5 above were in conformance with the rules of the Michigan Board of Land Surveyors or by a Decree of a Court of Law; established, re-established, monumented, recovered, found as expressed below:

**NOTE:** Not more than 2 corners, all in the same town and range, may be recorded on this certificate.

**A. Description of original monument and accessories and/or subsequent restoration:**


- (10-Sec. 24) South 1/16 corner between Sections 23-24. Not established in the original survey.
- (12-Sec. 24) South 1/16 corner, Section 24. Not established in the original survey.

**B. Description of corner evidence found and/or method applied in restoring or reestablishing corner:**

- (10-Sec. 24) Established the corner midway and on a straight line between Section corner 1318.03' south and Quarter corner 1318.03' north.
- (12-Sec. 24) Established the corner midway and on a straight line between Quarter corner 1318.59' south and Center of Section 1318.59' north.

**C. Description of monument for corner and accessories established to perpetuate locating the position of the corner:**

- |   |   |
|---|---|
| (10) Set 1"IDx32" I.pipe with 4" alum. MDNR cap. Blazed, scribed, and set measuring nails in: | (12) Set 1"IDx32" I.pipe with 4" alum. MDNR cap. Blazed, scribed, and set measuring nails in: |
| 7" Y.Birch N70E 71.5' "1/16S BT"  | 5" Sugar N14E 26.45' "1/16S BT"   |
| 8" Maple S29E 19.0' do  | 5" Sugar N64E 8.5' do   |
| 6" Sugar S62W 42.7' do  | 12" Sugar S53W 6.6' do  |
| 6" Y.Birch N38W 12.3' do  | 7" Sugar N77W 23.2' do  |
| Set sq'd cedar post adjacent. Bearings are magnetic. Distances are to nail with tag.          | Set sq'd cedar post adjacent. Bearings are magnetic. Distances are to nail with tag.          |

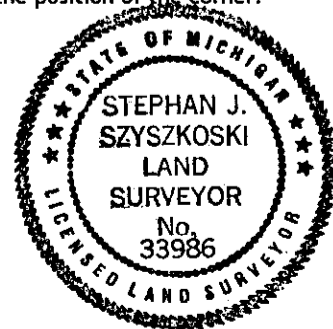

Signed by Stephan J. Szyszkoski  
 Surveyor's Michigan License No. 33986

Date 11/3/03