

LAND CORNER RECORDATION CERTIFICATE
Filing Requirement of Act 74, Mich. P.A. 1970 as Amended

For corners in

<u>Houghton</u> (County)	Located In:	Corner Code #
1. Public Land Survey	T <u>51N</u> R <u>36W</u>	<u>M10</u>
	T _____ R _____	_____
	T _____ R _____	_____
2. Property Controlling in Section	S _____ T _____ R _____	_____
	S <u>25</u> T <u>51N</u> R <u>36W</u>	<u>7</u>
	S _____ T _____ R _____	_____
3. Miscellaneous Property in Sec.	S _____ T _____ R _____	_____
	S _____ T _____ R _____	_____
4. Lot No. _____, Recorded Plat _____		
5. Private Claims		

Register of Deeds Stamp & File Number

A	B	C	D	E	F	G	H	I	J	K	L	M
1												
2	6	5	4	3	2	1						
3												
4	7	8	9	10	11	12						
5												
6	18	17	16	15	14	13						
7												
8	19	20	21	22	23	24						
9												
10	30	29	28	27	26	25						
11												
12	31	32	33	34	35	36						
13												

Oct 21 2003

I, Stephan J. Szyszkoski, in a field survey on _____, 20____ do hereby state that under requirements of P.A. 74, Michigan P.A. of 1970, the corner points mentioned in lines 1 and 2 above were in conformance with regulations and rules therefore as required in the current manual of survey instructions of the United States Department of the Interior, Bureau of Land Management or by a decree of a Court of Law and /or that the corner points mentioned in lines 3, 4 and 5 above were in conformance with the rules of the Michigan Board of Land Surveyors or by a Decree of a Court of Law; established, re-established, monumented, recovered, found as expressed below:

NOTE: Not more than 2 corners, all in the same town and range, may be recorded on this certificate.

A. Description of original monument and accessories and/or subsequent restoration:


(M10) Quarter corner common to Section 25 T51N-R36W and Section 30 T51N-R35W. 1845: Established by Austin Burt: North on East side of Section 25...40.00 Set qr. Section post. Sugar 8 S55W 23, Sugar 9 N08E 15...80.00 Set post corner of Sections 24 & 25. (7-Sec. 25) North 1/16 corner between Section 25 T51N-R36W and 30 T51N-R35W. Not established in the original survey.

B. Description of corner evidence found and/or method applied in restoring or reestablishing corner:

(M10) The original post and accessories were not recovered. Reestablished the corner midway and on a straight line between Section corners 2645.32' North and South. From the corner thus established, I found a 15" Sugar with numerous blazes around its trunk N42E 7.5' for an approximate corner. (7-Sec. 25) Established the corner midway and on a straight line between Quarter corner 1322.66' South and Section corner 1322.66' North.

C. Description of monument for corner and accessories established to perpetuate locating the position of the corner:

(M10) Set 1" IDx32" I.pipe with 4" alum. MDNR cap. Blazed, scribed, and set measuring nails in: 15" Sugar N42E 7.5' "1/4S NBT" 8" Sugar S38E 43.4' do 12" Sugar S36W 23.1' do 6" Y.Birch N64W 20.9' do Set sq'd cedar post adjacent. Bearings are magnetic. Distances are to nail with tag.	(7) Set 1" IDx32" I.pipe with 4" alum. MDNR cap. Blazed, scribed, and set measuring nails in: 14" Sugar N03W 15.1' "1/16S BT" 8" Maple S12E 24.6' do 8" Sugar S60W 33.2' do 5" Sugar N36W 9.9' do Set sq'd cedar post adjacent. Bearings are magnetic. Distances are to nail with tag.
--	---

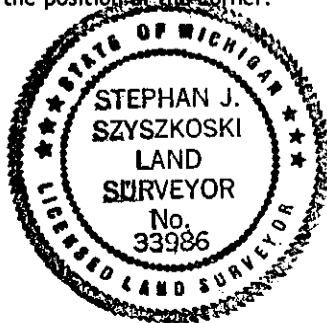

Signed by Stephan J. Szyszkoski
 Surveyor's Michigan License No. 33986

Date 11/3/03

For the Michigan Department of Natural Resources, Office of Land and Facilities