

MICHIGAN
DEPARTMENT OF CONSERVATION
FORESTRY DIVISION

LAND CORNER RECORD

T. 51 N.R. 36 W


Houghton COUNTY

DESCRIPTION OF CORNER 1/4 Corner between Secs. 21-28

CORNER MONUMENT 1" Pipe with 4" Aluminum Cap

DATE MONUMENT PLACED AND WITNESSED 7/27/66

WITNESSES TO CORNER..... 13" Hard Maple (1/4S NBT), S 35° E, 10 lks.

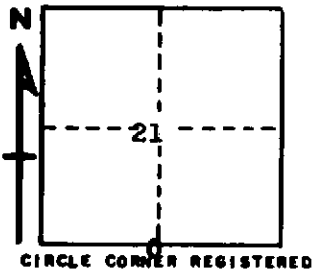

9" Y. Birch (1/4S NBT), N 02° E, 36 lks.

AND

DESCRIPTION IN DETAIL AS TO HOW CORNER WAS LOCATED AND IDENTIFIED OR RESTORED.

Re-established this corner midway and on line between two Section Corners.
Found no evidence of Original Corner, but did find a line of blazes both
East and West of the corner.

SURVEYOR'S SEAL

SIGNED *Billy D. Buckler*
Billy D. Buckler
REGISTERED LAND SURVEYOR

DATE 8/12/1966