CHEVEV &

#

í		₹EŘ	·		Epotentia, modernom since \$			R		NUME		TIOI	N
For	P.C. Houghton Cou Role W. (nty Court			R RECORDAT				J	N 0 9	1998	}	
	Houghton (County)		Located	i in:	Corner Code	HOU	CY FE	COU	I NTY	ECTI 2/11/	97	11	:26
1.	Public Land Survey		T T	R <u>34W</u> R R	M-7*	LC	3	/ 46		U Fee Page		of.	1.00 2
3. I	Property Controlling in Section Miscellaneous Property in Sec.	S_ S_ S_ S_	T	R R R R				Regi	ster of	Deeds \$	Stamp (3. File	Number
4. I	Lot No, Private Claims	Recorded	l Plat					V B	с ъ	e f	G H	1 J	K Ł
l, undo abo surv deci conf	Michael Mileski er requirements of P.A. ve were in conformance vey instructions of the U ree of a Court of Law a formance with the rules bblished, re-established, r	74, Michige with regunited State and /or the of the Michigan (Control o	gan P.A. of 19 plations and rul s Department of the corner po higan Board of	70, the corner les therefore as of the Interior, B lints mentioned Land Surveyors	points mentioned required in the cureau of Land Ma in lines 3, 4 and or by a Decree o	in lines 1 a current manu nagement or 5 above we	and 2 all of by a ere in Law;	1 2 6 - 3	8-17	9	10	11	
NO.	TE: Not more than 2 on this certificate		all in the same	e town and ra	nge, may be red	corded		7 - - - - - - - - -	20			. -	25-
A.	Description of origina	al monum	ent and acces	ssories and/or	subsequent res	toration:	·	31-	32-	33	34	_ 35	36-
М-:	7; Section Corner	commo	n to Sectio	ns 13 and	24, T52N, R	34W;							
	See back of fo	rm.						•					
В.	Description of corne	r evidence	e found and/o	r method app	lied in restoring	or reestabl	ishing co	rner:					
M-:	7; Section Corner	commo	n to Sectio	ns 13 and	24, T52N, R	34W;							
	Found a 1½" (Replaced this r corner falls on available evide	nonume the phy	nt with a 1 sical cente	" (I.D.) $ imes$ 3 rline of a no	6" galvanize orth-south, 1	d iron pip	e with	cap st	ampe	d as to	locat	ion.	This
C.	Description of monu	ment for	corner and ac	cessories esta	ablished to perp	etuate loca	ting the p	osition	of the	corner:			
M-7	7; Section Corner	commo	n to Sectio	ns 13 and	24, T52N, R	34W;							
	Set a 1" (I.D.) 8" below the s		alvanized ir	on pipe wit	h cap stamp	ed as to	location	ı					
	i) Set 7" s ii) Set 7" s iii) Set 7" s iv) Set 7" s v) Set 7" s	spike N spike N spike N	IW/side I/side I/side I/side I/side	6" Sugai 24" Twii 8" Sugai 9" Sugai 12" Suga	n Red Maple Maple	N47°E N80°E S63°E S60°W N72°W	1) 3: 1:	1.32' 6.73' 3.63' 8.78' 9.81'					


(i) and (iii) are marked with upper and lower blazes. The lower blaze is scribed "NBT". Both blazes and a band around the tree at the upper blaze were painted red.


6" Steel fence post w/ yellow sign West

(ii), (iv), and (v) are Mr. Sackett's new bearing trees and are further described in Part A. These new bearing trees were also painted red.

*This corner is also A-7 of T52N, R33W.



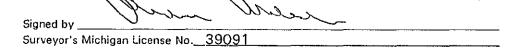

 

20.31

6

A. Description of original monument and accessories and/or subsequent restoration:

M-7; Section Corner Common to Sections 13 and 24, T52N, R34W;

Originally established during U.S. Survey conducted by William Burt, D.S. in 1845 and monumented with a wood post witnessed by a

Sugar

N43°E

43 lks.

and a

Sugar

13

N21°W

42 lks.

During the subdivision of T52N, R33W, by William Burt, D.S. in 1849, this corner was further witnessed by a

Yellow Birch 15

S22°E

26 lks.

and a

Sugar

12

N421/2°E

42 lks.

On 18 April 1977, Keith Sackett, P.S. #19006 recovered and accepted a "1½ (in.) I.D. x unknown length iron pipe buried in old logging road". According to a Land Corner Recordation Certificate prepared by Mr. Sackett dated 3 August 1977 and recorded on 20 December 1977 in Volume 1 on page 483 of the Houghton County Land Corner Records, this monument was left in place and the following accessories were established: established:

9" Sugar Maple

S58°W

18.4

Presently alive and 10" in diameter having partially healed upper and lower blazes with scribing visible. Set 7" spike

N/side

Measured

S60°W

18.78

12" Sugar Maple

N69°W

19.2

Presently alive and 15" in diameter having partially healed upper and lower blazes with

scribing visible. Set 7" spike

N/side

N72°W Measured

19.81

16" Maple

N80°E

16.2

Found an alive twin red maple 14" in diameter having partially healed upper and lower

blazes with scribing visible. Set 7" spike N/side

Measured

N80°E

16.73