

**LAND CORNER RECORDATION CERTIFICATE**  
**Filing Requirement of Act 74, Mich. P.A. 1970**

For corners in  
Houghton

(County)

Located In:

Corner Code #

1. Public Land Survey

T \_\_\_ R \_\_\_  
 T \_\_\_ R \_\_\_  
 T \_\_\_ R \_\_\_  
 T \_\_\_ R \_\_\_

2. Property Controlling  
 in Section

S 25 T 52N R 35W 7

3. Miscellaneous  
 Property in Sec.

S \_\_\_ T \_\_\_ R \_\_\_  
 S \_\_\_ T \_\_\_ R \_\_\_

Register of Deeds Stamp & File Number

4. Lot No. \_\_\_\_\_, Recorded Plat \_\_\_\_\_

5. Private Claims \_\_\_\_\_

Oct 28 2004

I, Stephan J. Szyszkoski, in a field survey on \_\_\_\_\_, 19\_\_\_\_ do hereby state that under requirements of P.A. 74, Michigan P.A. of 1970, the corner points mentioned in lines 1 and 2 above were in conformance with regulations and rules therefore as required in the current manual of survey instructions of the United States Department of the Interior, Bureau of Land Management or by a decree of a Court of Law and /or that the corner points mentioned in lines 3, 4 and 5 above were in conformance with the rules of the Michigan Board of Land Surveyors or by a Decree of a Court of Law; established, re-established, monumented, recovered, found as expressed below:

NOTE: Not more than 2 corners, all in the same town and range, may be recorded on this certificate.

1	A	B	C	D	E	F	G	H	I	J	K	L	M
2		6		5		4		3		2		1	
3													
4		7		8		9		10		11		12	
5													
6		18		17		16		15		14		13	
7													
8		19		20		21		22		23		24	
9													
10		30		29		28		27		26		25	
11													
12		31		32		33		34		35		36	
13													

**A. Description of original monument and accessories and/or subsequent restoration:**


(7-Sec. 25) North 1/16 corner between Section 25 T52N-R35W and Section 30 T52N-R34W. 1972 - Established by A.O. Enger RLS at an old fence corner, which was found to be on line between Section corner 19.976 ch. N and 1/4 corner 19.976 ch. S. Set 1"IDx36" iron pipe with 4" aluminum cap. Sugar Maple 9 S52E 30.9', Red Maple 6 S16W 4.4'.

**B. Description of corner evidence found and/or method applied in restoring or reestablishing corner.**

(7-Sec. 25) Recovered the 1972 monument in good condition and at record bearing and distance from the 1972 witnesses: The Sugar SE is a rotted stump, the Maple SW is a standing dead stub with scribing visible. Left the monument in place, cut the Maple BT SW to facilitate GPS observations, and made new witnesses as described below.

**C. Description of monument for corner and accessories established to perpetuate locating the position of the corner**

(7) Found 1" ID I. pipe with 4" alum. MI Dept of Conservation cap. Set measuring nails in:  
 7" Sugar N72E 39.6' mrkd "1/16S BT"  
 7" W.Spruce S79E 16.2' do  
 6" Sugar S33W 23.6' do  
 7" W.Spruce N16W 30.7' do  
 Set sq'd spruce post adjacent. Bearings are magnetic. Distances are to nail with plastic tag.

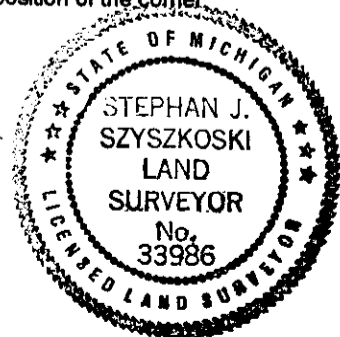

Signed by Stephan J. Szyszkoski  
 Surveyor's Michigan License No. 33986

Date 11/16/04

For the Michigan Department of Natural Resources - Office of Land and Facilities