

LAND CORNER RECORDATION CERTIFICATE
Filing Requirement of Act 74, Mich. P.A. 1970

For corners in
Houghton
 (County)

Located in: _____ Corner Code # _____

1. Public Land Survey
 T ___ R ___
 T ___ R ___
 T ___ R ___
 T ___ R ___

2. Property Controlling in Section
 S 25 T S2N R 35W C-S-NE 1/64
 S 25 T S2N R 35W C-N-SE 1/64

3. Miscellaneous Property in Sec.
 S ___ T ___ R ___
 S ___ T ___ R ___

Register of Deeds Stamp & File Number

4. Lot No. _____, Recorded Plat _____
 5. Private Claims _____

Oct 28 2004

I, Stephan J. Szyszkoski, in a field survey on _____, 19 ___ do hereby state that under requirements of P.A. 74, Michigan P.A. of 1970, the corner points mentioned in lines 1 and 2 above were in conformance with regulations and rules therefore as required in the current manual of survey instructions of the United States Department of the Interior, Bureau of Land Management or by a decree of a Court of Law and /or that the corner points mentioned in lines 3, 4 and 5 above were in conformance with the rules of the Michigan Board of Land Surveyors or by a Decree of a Court of Law; established, re-established, monumented, recovered, found as expressed below:

NOTE: Not more than 2 corners, all in the same town and range, may be recorded on this certificate.


A	B	C	D	E	F	G	H	I	J	K	L	M
1												
2	6		5		4		3		2		1	
3												
4	7		8		9		10		11		12	
5												
6	18		17		16		15		14		13	
7												
8	19		20		21		22		23		24	
9												
10	30		29		28		27		26		25	
11												
12	31		32		33		34		35		36	
13												

A. Description of original monument and accessories and/or subsequent restoration:
 (C-S-NE 1/64 Sec. 25) The center-south 1/64 corner of the NE 1/4 of Sec. 25, being the SE corner of the NE1/4 of the SW1/4 of the NE1/4 of Sec. 25. Not established in the original survey.
 (C-N-SE 1/64 Sec. 25) The center-north 1/64 corner of the SE1/4 of Sec. 25, being the SE corner of the NE1/4 of the NW1/4 of the SE1/4 of Sec. 25. Not established in the original survey.

B. Description of corner evidence found and/or method applied in restoring or reestablishing corner:
 (C-S-NE 1/64) Established the corner midway and on a straight line between the NE1/16 corner and the E1/16 corner of Sec. 25 658.80' north and south.
 (C-N-SE 1/64) Established the corner midway and on a straight line between the East 1/16 corner of Sec. 25 659.01' north and the SE1/16 corner of Sec. 25 (unmonumented) 659.01' south.

C. Description of monument for corner and accessories established to perpetuate locating the position of the corner:

(C-S-NE 1/64) Set 1"IDx32" I.pipe with 4" alum. MDNR cap. Set measuring nails in: 5" Ash N85E 1.9' mrkd "1/64S NBT" 7" Cedar S68E 47.6' do 7" Sugar S37W 44.1' do 10" Cedar N62W 30.3' do Set sq'd cedar post adjacent. Bearings are magnetic. Distances are to nail with plastic tag.	(C-N-SE 1/64) Set 1"IDx32" I.pipe with 4" alum. MDNR cap. Set measuring nails in: 6" Cedar N37E 18.8' mrkd "1/64S NBT" 8" Sugar S76E 22.5' do 15" Maple S39E 5.9' do 4" Cedar N83W 10.4' do Set sq'd cedar post adjacent. Bearings are magnetic. Distances are to nail with plastic tag.
---	---

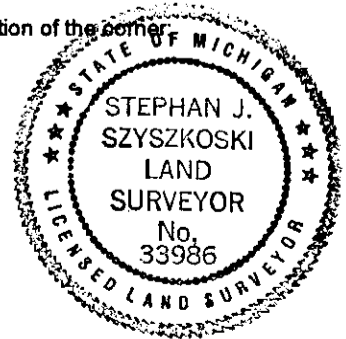

Signed by Stephan J. Szyszkoski Date 11/16/04
 Surveyor's Michigan License No. 33986